
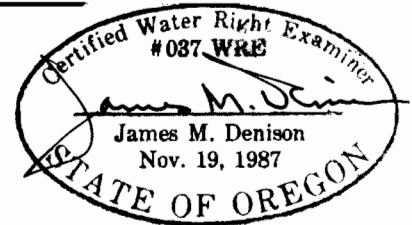


T. 9 S., R. 10 W., W.M.

S 1/2 of the SE 1/4, Sec. 33
LINCOLN COUNTY, OREGON

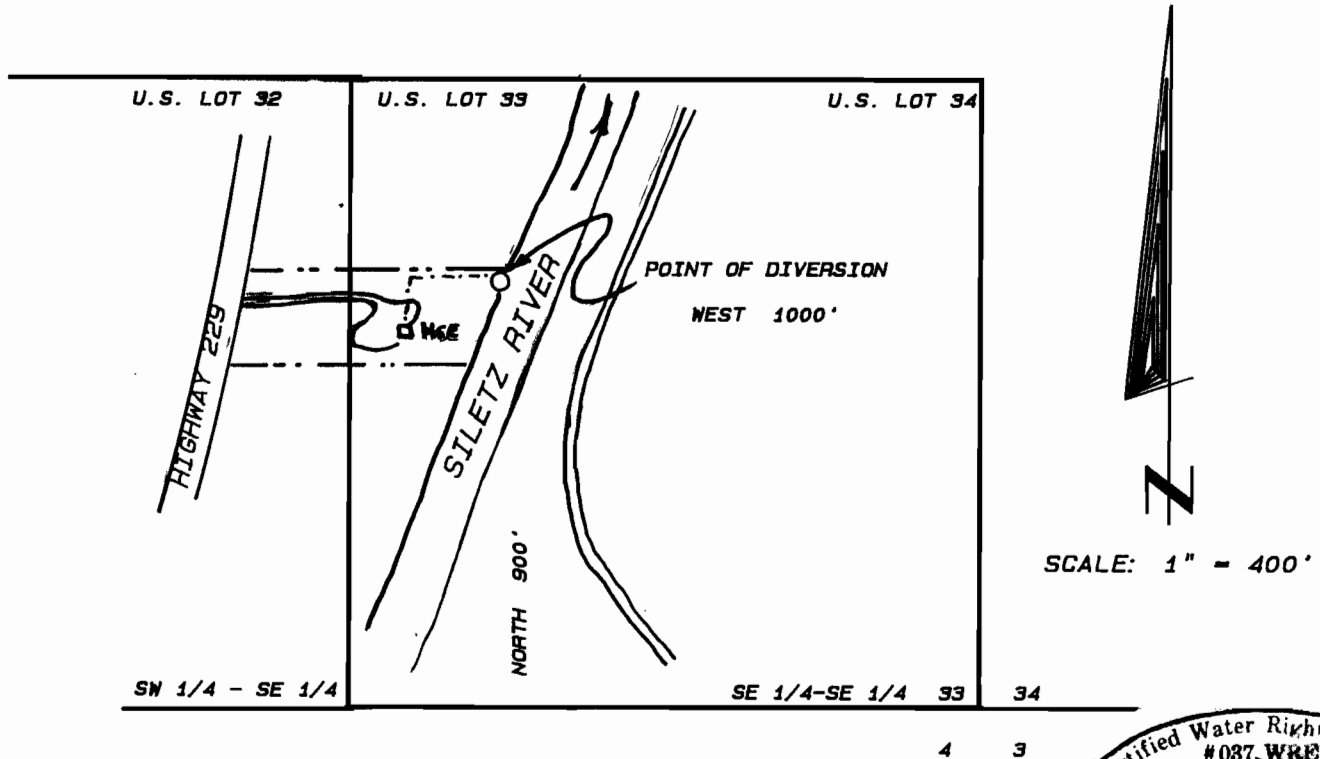

FINAL PROOF SURVEY UNDER

Application No. 69463, Permit No. 50189

IN NAME OF

Paula Hurd

Surveyed June 12, 1989 by James M. Denison

This map is prepared solely for the purpose of showing location of a water right, and is not intended for use to provide dimensions or location of property ownership lines.