


T.7S.R.1W.W.M.

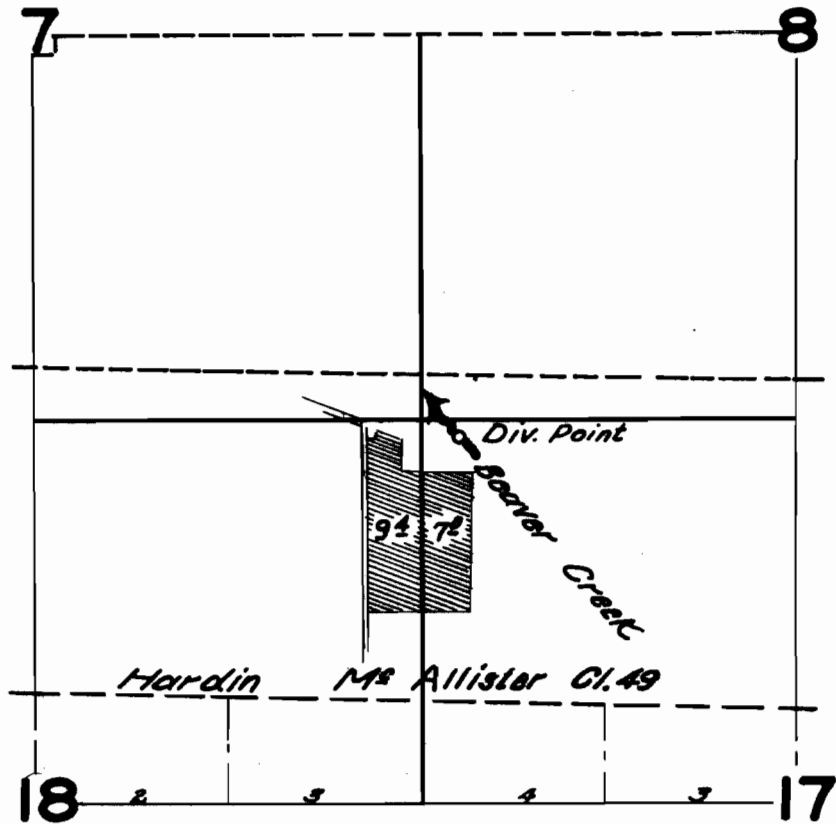

FINAL PROOF SURVEY

UNDER

Application No. 23906 Permit No. 19437

IN NAME OF

WENGER Bros.

Surveyed August 7 19 52, by H. L. COFFMAN