


T.7 S.R. 1 W. W.M.

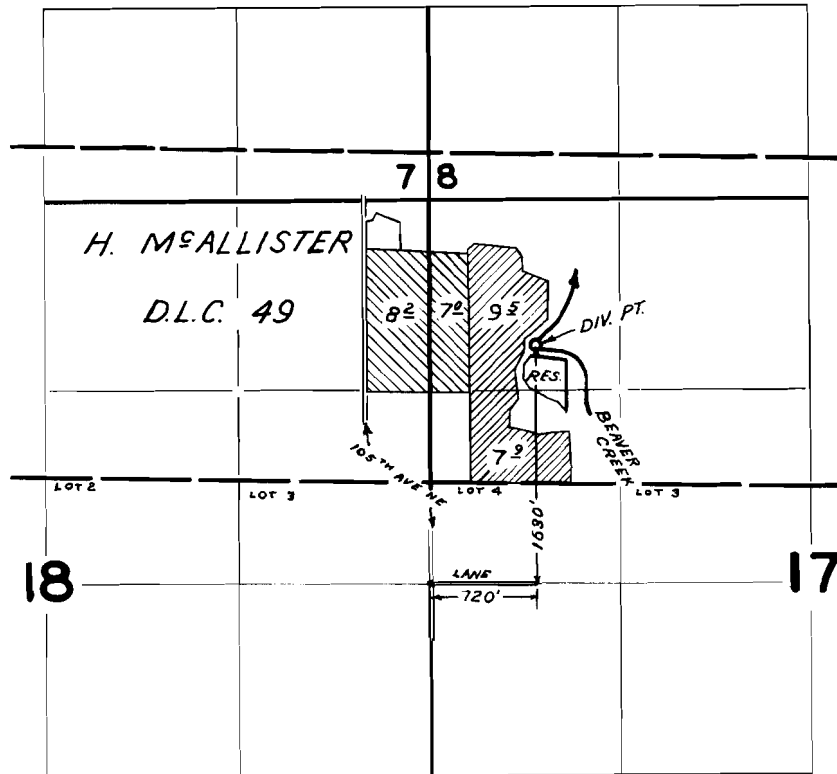

 PRIMARY  SUPPLEMENTAL

FINAL PROOF SURVEY
UNDER

Application No. R-37260 37261 Permit No. R-2709 27759

IN NAME OF

WENGER BROS.

Surveyed APR. 23 1965, by L. COLEBANK