


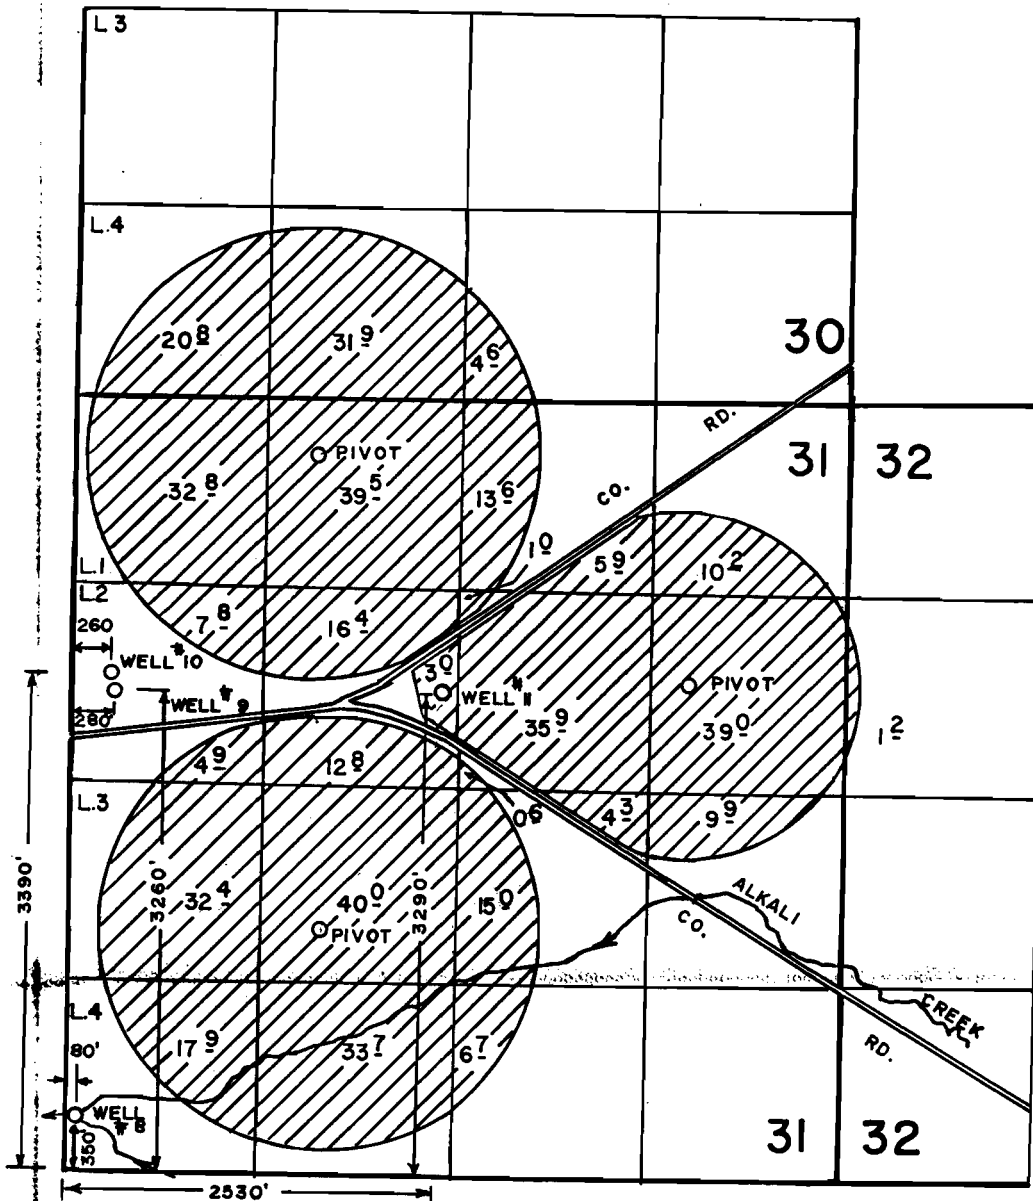

1"=1320'



T. 16 S., R. 24 E., W.M.

**FINAL PROOF SURVEY**  
UNDER

Application No. G-7642 Permit No. G-7345.....  
IN NAME OF

BEDORTHA RANCHES, INC.

Surveyed MARCH 15 1990, by B.W. BISHOP.....

6-6-90 DSM  
P.T.S.- 41013-280-21 D

#1 of 2  
G-7345