


# T. 26S., R. 34E., W.M.

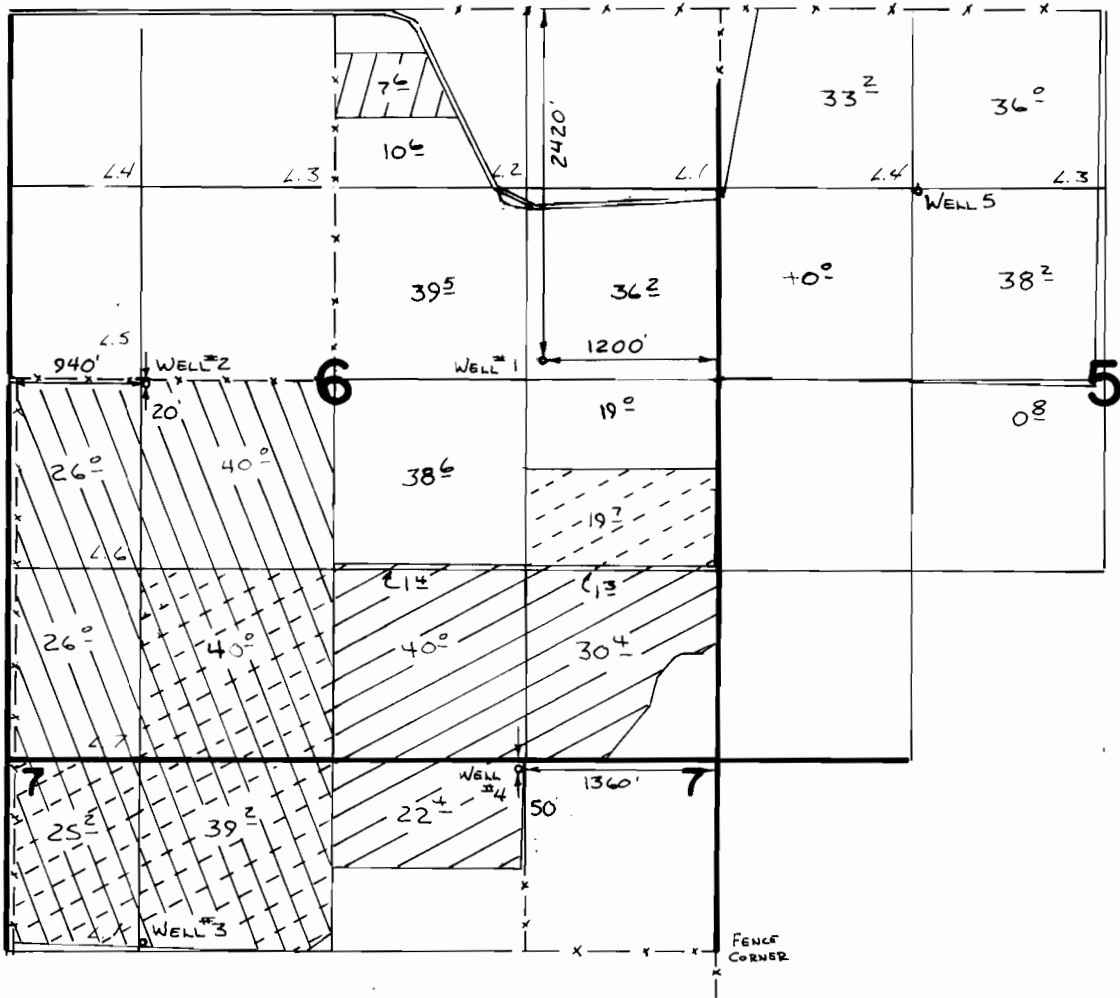

- WELL #2 PRIM (G-7547)
- WELL #1 PRIM (G-8269)
- WELL #4 PRIM (G-8269)
- WELL #4 SUPPL (G-8269)



SCALE 1" = 1320'

## FINAL PROOF SURVEY UNDER

G-8720                      G-8269  
 Application No. **G-8096** Permit No. **G-7547**  
 IN NAME OF

.....  
 Surveyed 5-10 1988, by V.L. Church.....