


T. 30 S., R. 5 W., W. M.
SECTION 17

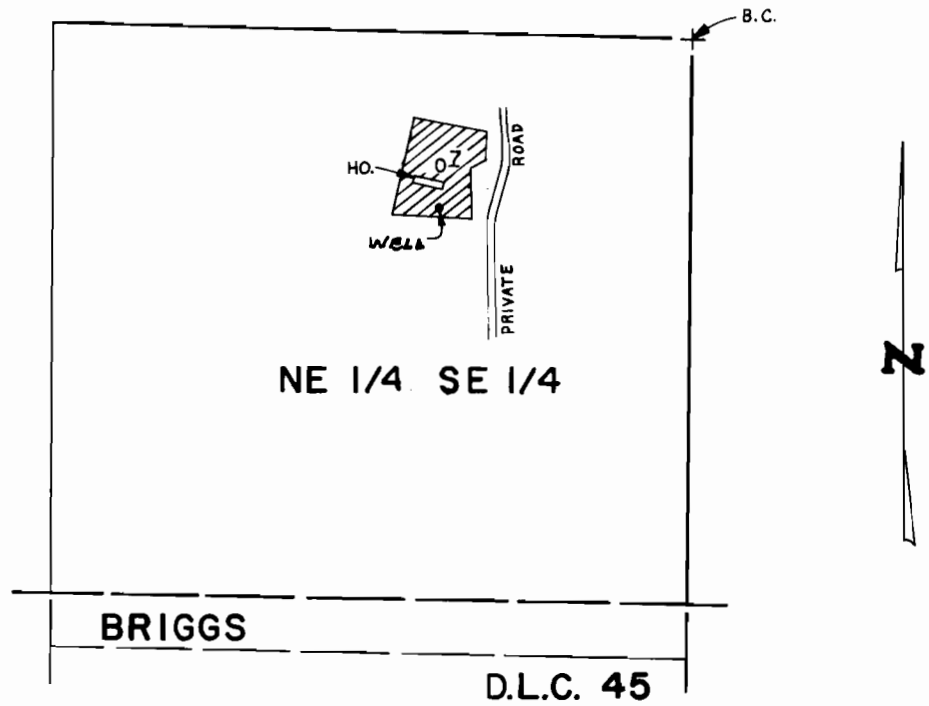

WELL LOCATED 345'S. & 525'W. FROM E. 1/4 COR. SEC. 17

SCALE: 1" = 400'

FINAL PROOF SURVEY
UNDER

Application No. G-9921. Permit No. G-9135....
IN NAME OF

BLANCHE B. THOMPSON

Surveyed JUN. 18, 1984, by L. CASHION...