


T. 11 S., R. 1 W., W.M.

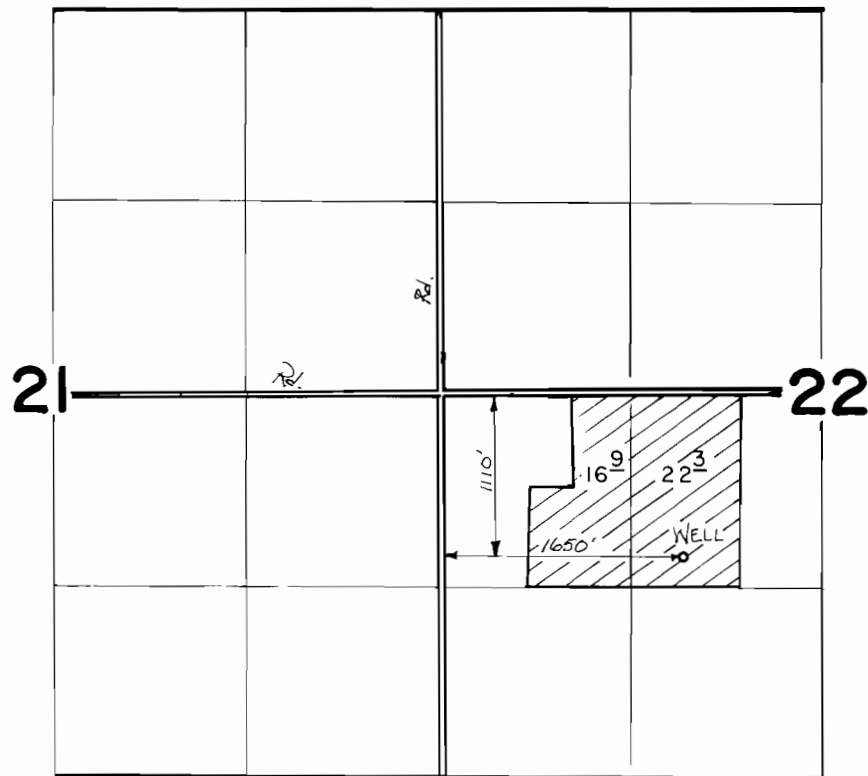

FINAL PROOF SURVEY
UNDER

Application No. G.9922. Permit No. G.9094...
IN NAME OF

DONALD V. GABRIELLI

Surveyed OCT. 18, 1983, by M. CAHILL