


T.15S. R.16E. W.M.

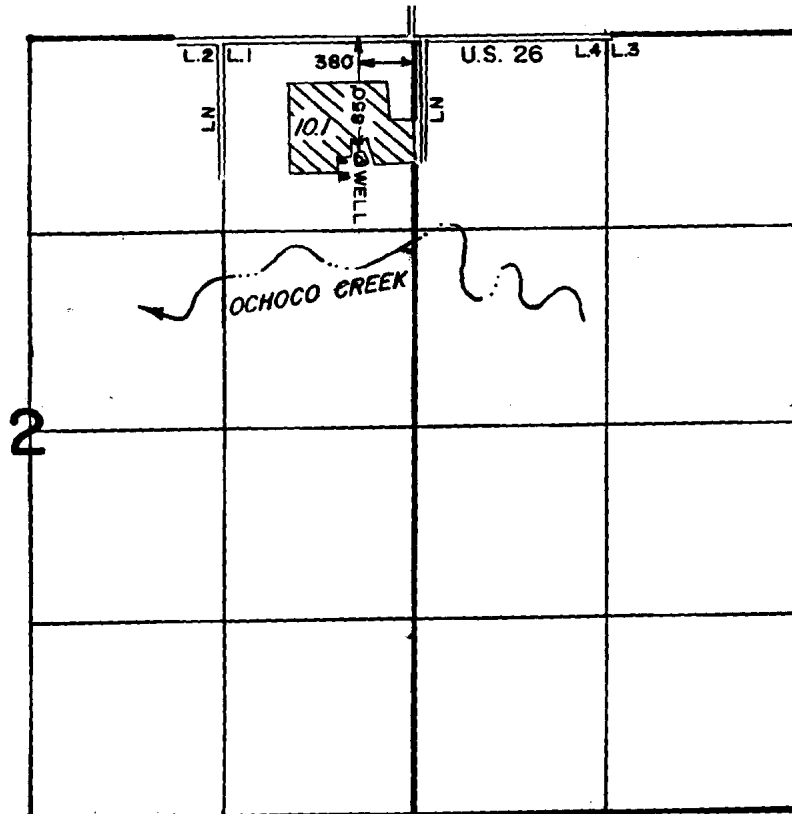

FINAL PROOF SURVEY
UNDER

Application No. G-9949 Permit No. G-9216.....
IN NAME OF

.....**DAVID & DORIS GRINDSTAFF**.....

Surveyed JUL. 20. 1982., by L.H. NUNN.....

64987

G-921