


T. 7 S., R. 1 W., W.M.

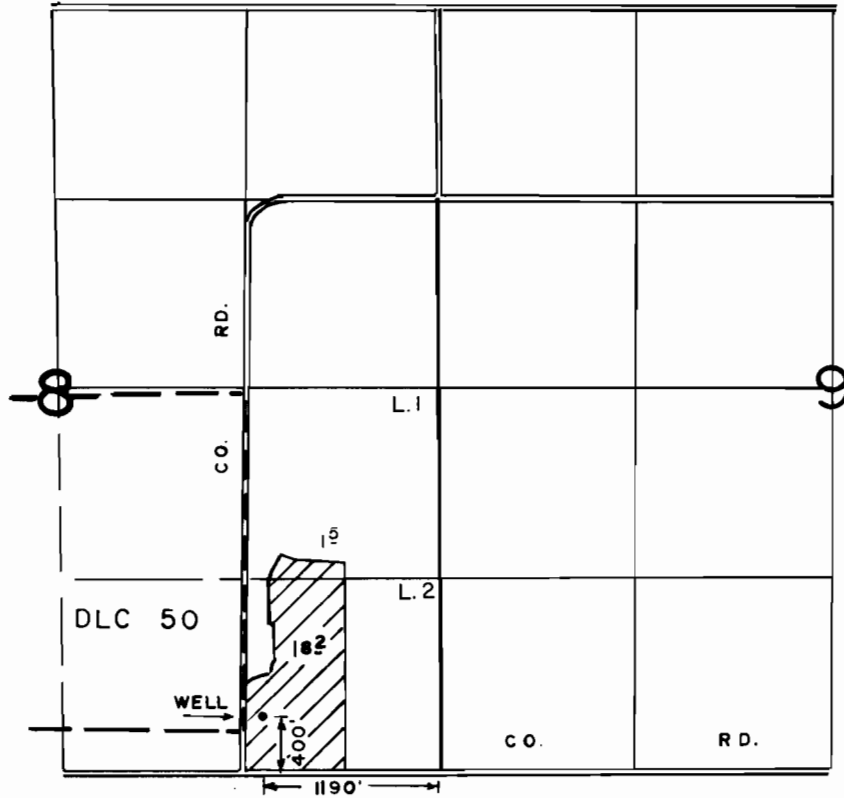

**FINAL PROOF SURVEY  
UNDER**

Application No. G-11476 Permit No. G-10614  
IN NAME OF

MERLE G. KAUFMAN

Surveyed MAY 29 1990, by T.M. WARREN

6-8-90 DSM  
41047-27 8-132 D