




T. 26 S., R. 16 E., W.M.

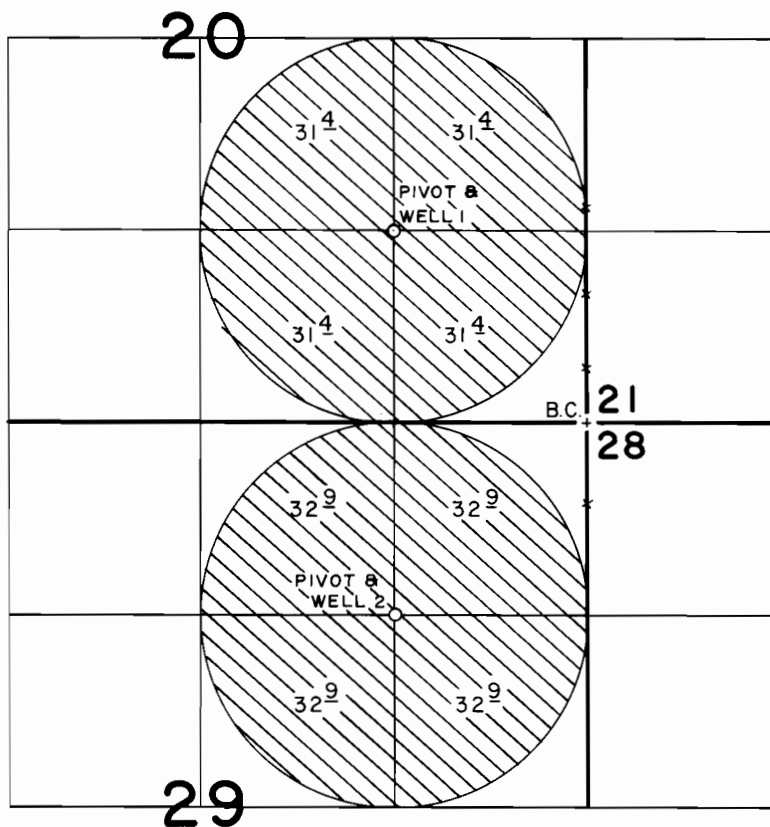

DIV. PTS LOC.: WELL 1 - 1310' N. & 1320' W., WELL 2 - 1320' S. & 1310' W.,
BOTH FROM SE CORNER OF SECTION 20.

SCALE: 1" = 1320'

FINAL PROOF SURVEY UNDER

Application No. G-11616... Permit No. G-10896..
IN NAME OF

DOROTHY B. MEYER

Surveyed APRIL 2, 1990, by B. W. BISHOP.