


T.IN., R.40E., W.M.

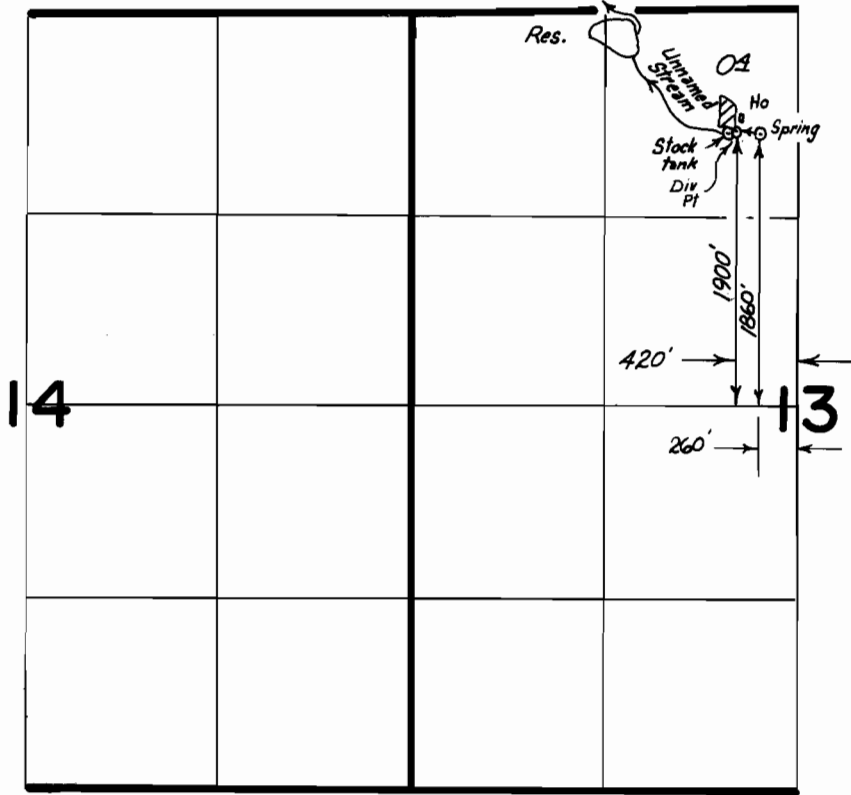

FINAL PROOF SURVEY UNDER

Scale: 1" = 1320'

R-52505 R-6303
 Application No. **52344** Permit No. **39366**.....
 IN NAME OF

WILLIAM & MARGARET OBERTEUFER

Surveyed ...4-6..... 1988., by ..Vern..Church.....