


T.1N., R.40E., W.M.

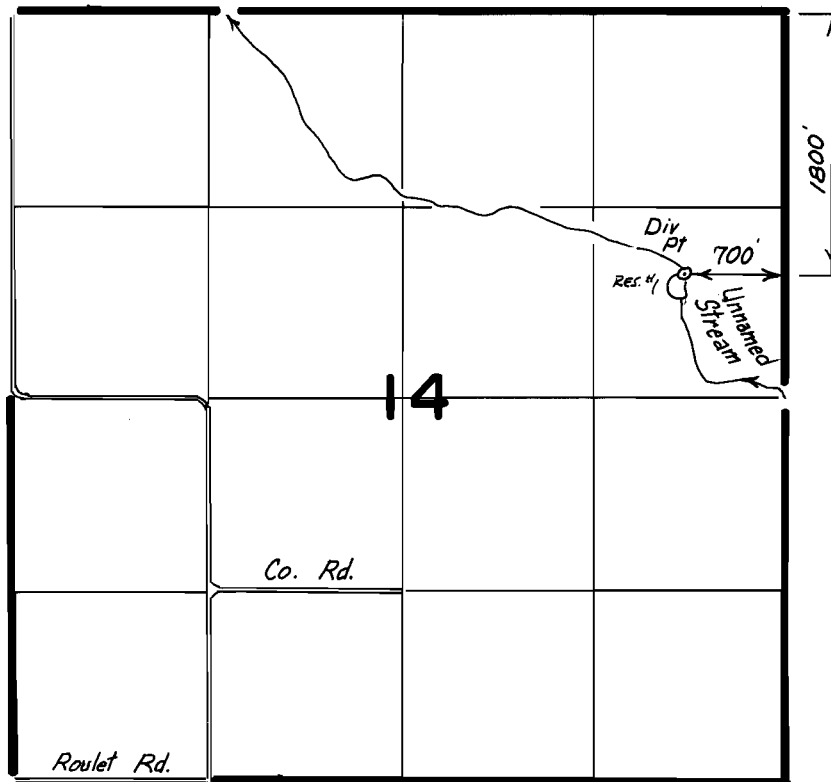


FINAL PROOF SURVEY
UNDER

R-52502 R-6351
Application No. 52952 Permit No. 39602
IN NAME OF

ESTILL J. ARRAND

Surveyed ...4-12... 1988, by Vern Church

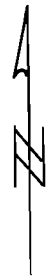

Scale: 1" = 1320'