
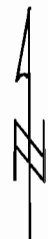


# T.IN., R.40E., W.M.

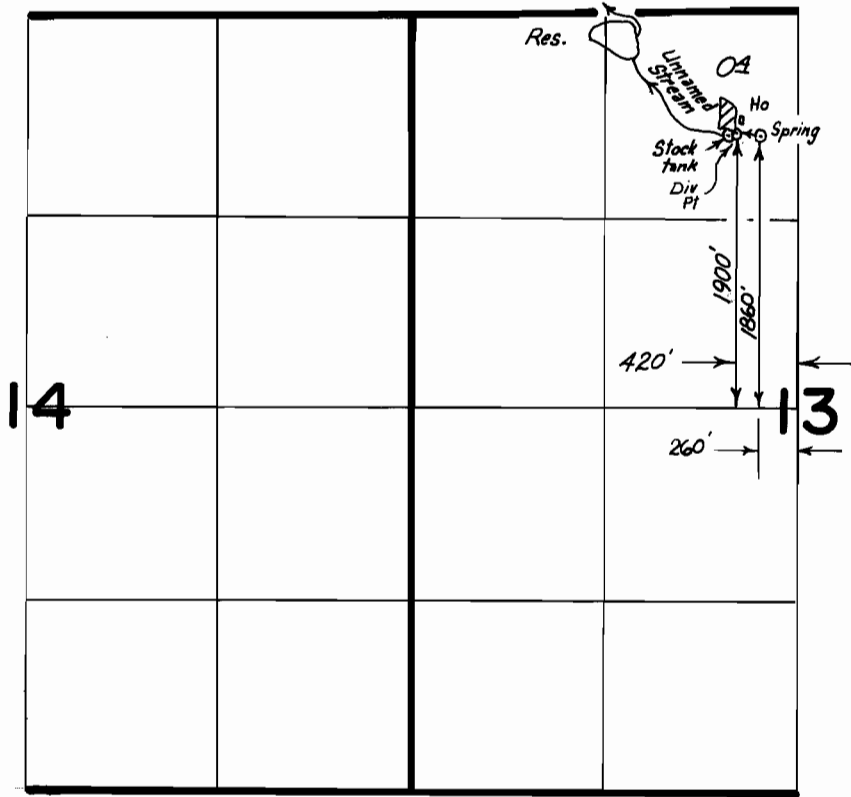

Scale: 1" = 1320'

## FINAL PROOF SURVEY UNDER

R-52505                      R-6303  
 Application No. **52344** Permit No. **39366**.....  
 IN NAME OF

**WILLIAM & MARGARET OBERTEUFER**

Surveyed ...4-6..... 1988., by ..Vern...Church.....