


T.1N., R.40E., W.M.

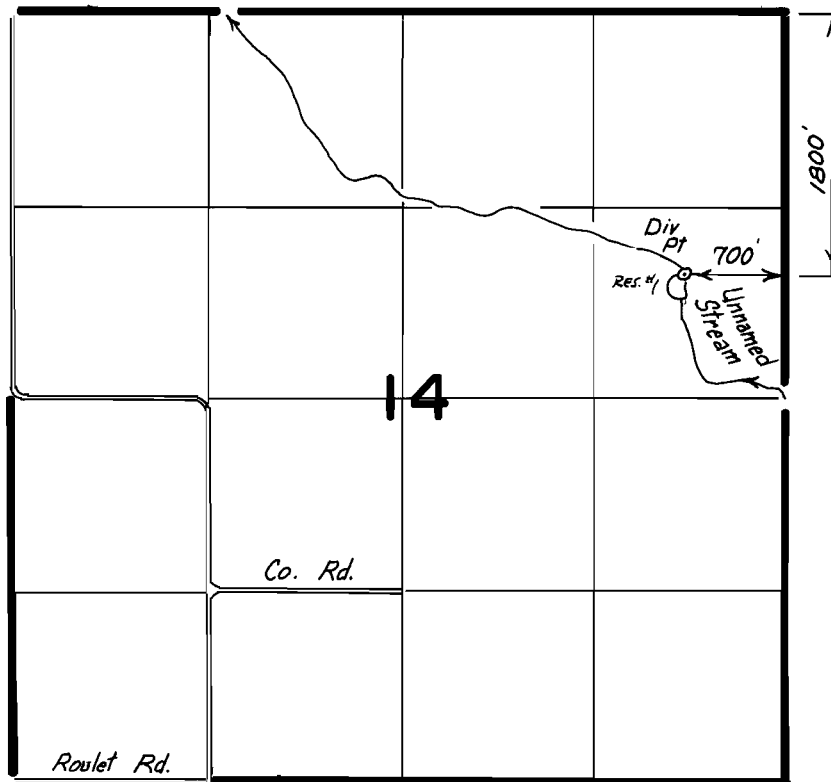


FINAL PROOF SURVEY
UNDER

R-52502 R-6351
Application No. 52952 Permit No. 39602
IN NAME OF

.....ESTILL J. ARRAND.....

Surveyed ...4-12... 1988., by ..Vern...Church.....

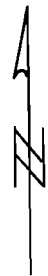

Scale: 1" = 1320'