


T. 40S., R. 14 W., W. M.

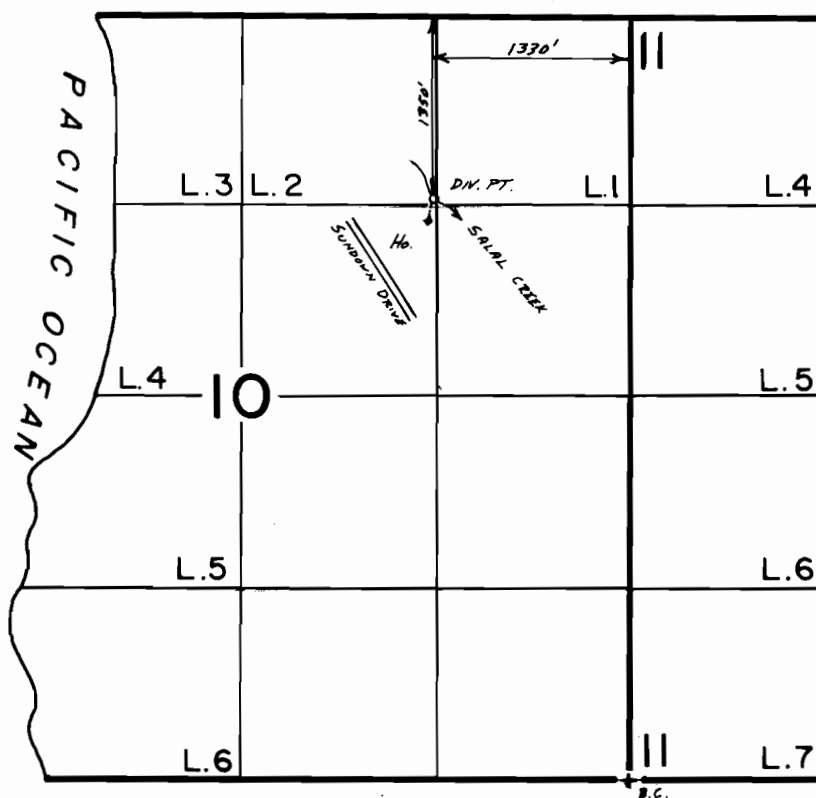

Scale 1"=1320'

FINAL PROOF SURVEY UNDER

Application No. 53576 Permit No. 40088.....
IN NAME OF

JAMES T. & MARGIE HULL.....

Surveyed Sept. 30, 1987, by B.S. JAMES.....