




T. 27 S., R. 11 W., W.M.

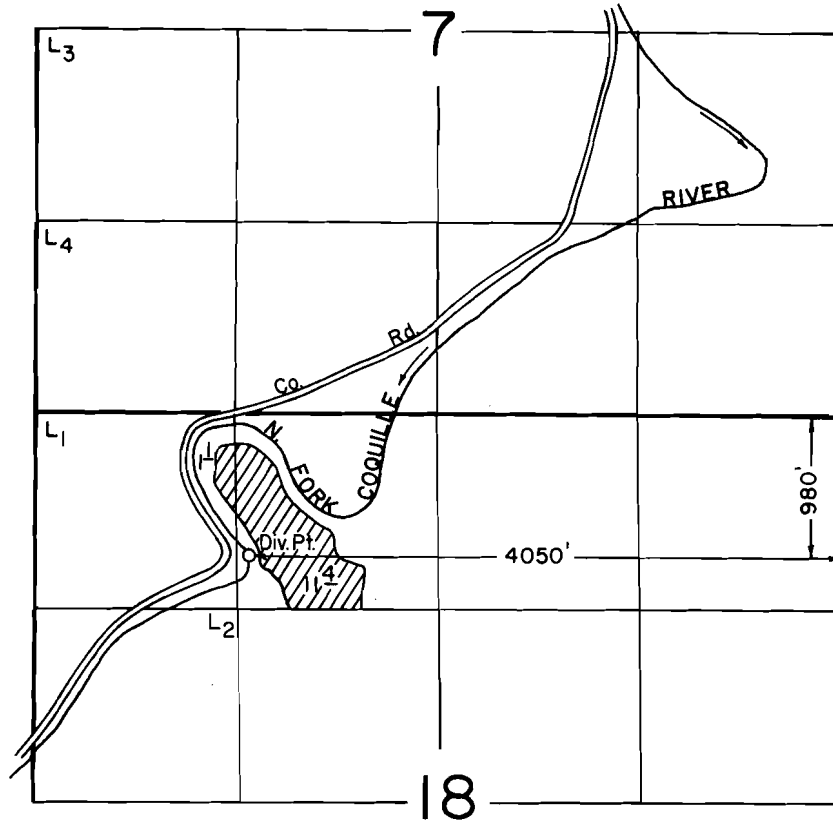

SCALE: 1" = 1320'

FINAL PROOF SURVEY
UNDER

Application No. 54330. Permit No. 40730
IN NAME OF

HAL E. & PATRICIA L. STRAIN

Surveyed SEPT. 20 1988, by Z. SALEH