


T.29S., R.14 W., W.M.

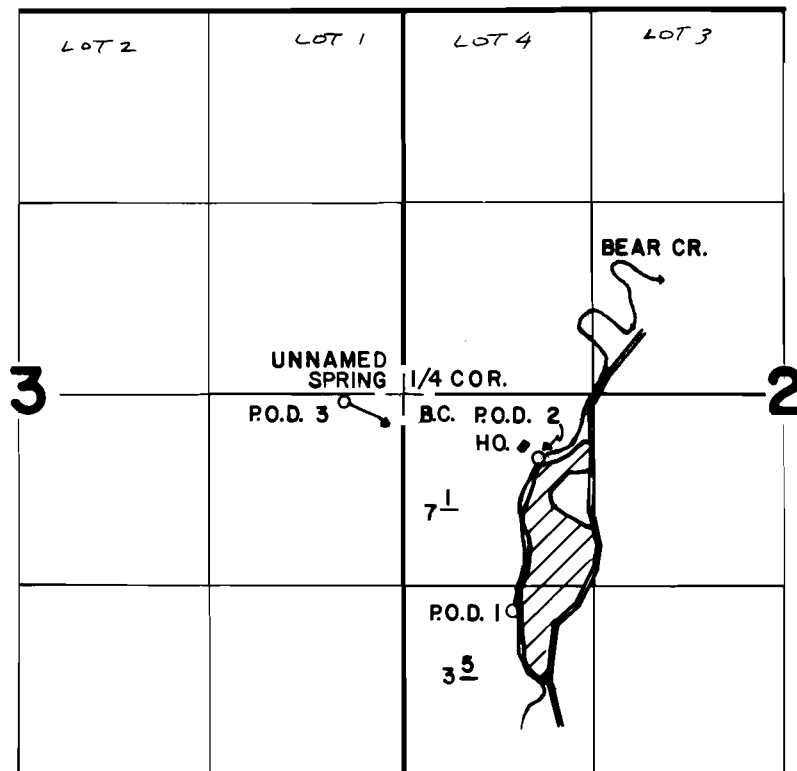

P.O.D. NO. 1 LOCATED 1480'S. & 750'E. OF W. 1/4 COR. SEC. 2.
P.O.D. NO. 2 LOCATED 450'S. & 940'E. OF W. 1/4 COR. SEC. 2.
P.O.D. NO. 3 LOCATED 50'S. & 400' W. OF E. 1/4 COR. SEC. 3.

SCALE: 4" = 1 MILE

FINAL PROOF SURVEY
UNDER

Application No. **54393** Permit No. **40762**
IN NAME OF

RICHARD HOWARD

Surveyed **OCT 23 1985**, by **J.M. SCHMORDE**