
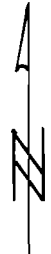


# T.7S., R.38E., W.M.

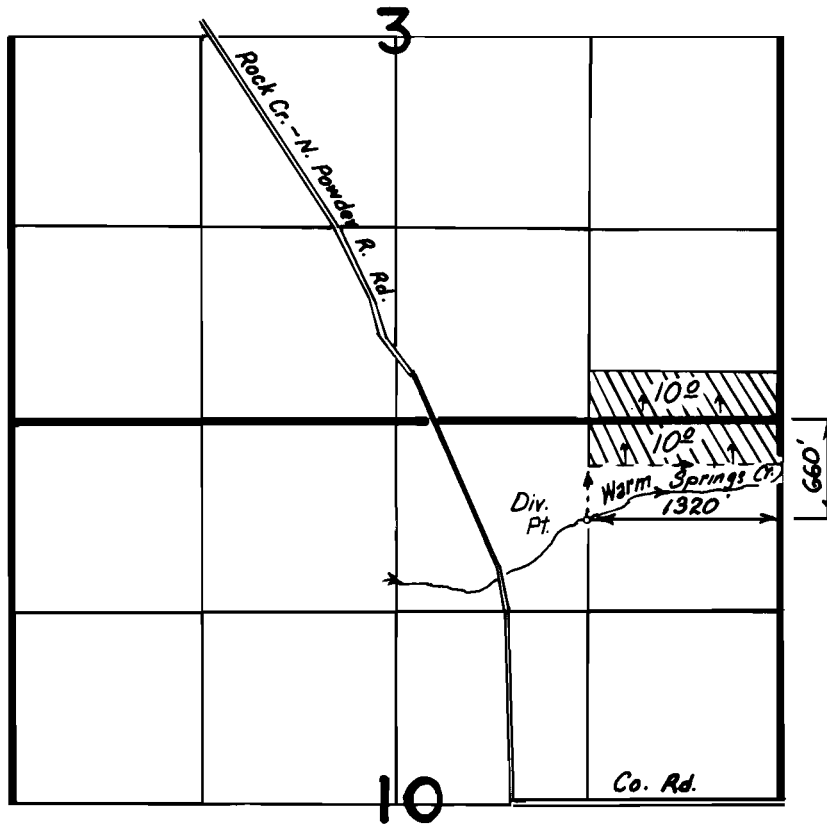

Scale: 1" = 1320'

## FINAL PROOF SURVEY

UNDER

Application No. 54726 Permit No. 43101.....  
IN NAME OF

BILLY R. & DORIS M. LEGGETT.....

Surveyed ...9-30... 1987., by ..Vera..Church.....