




T. 29 S., R. 9 E., W.M.

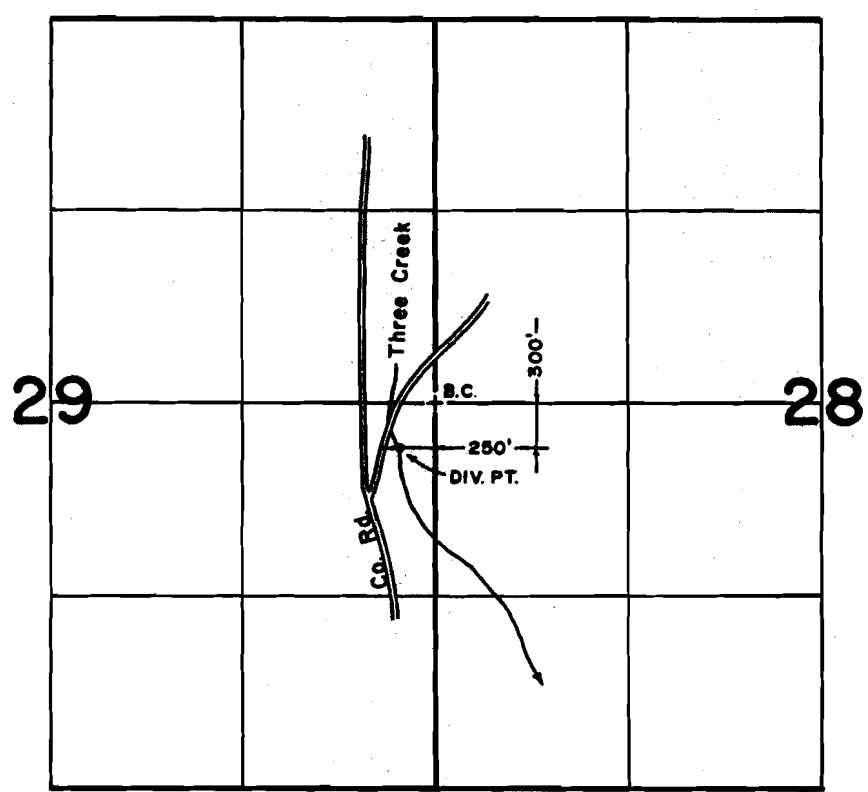

SCALE: 1" = 1320'

FINAL PROOF SURVEY UNDER

Application No. 55061.. Permit No. 44370....
IN NAME OF

JAMES RIVER CORPORATION OF NEVADA.....

Surveyed APRIL 30 1990., by .B.W.BISHOP...