



T. 3 S. R. 40 E. W. M.

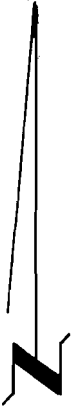

SCALE: 1"=1320'

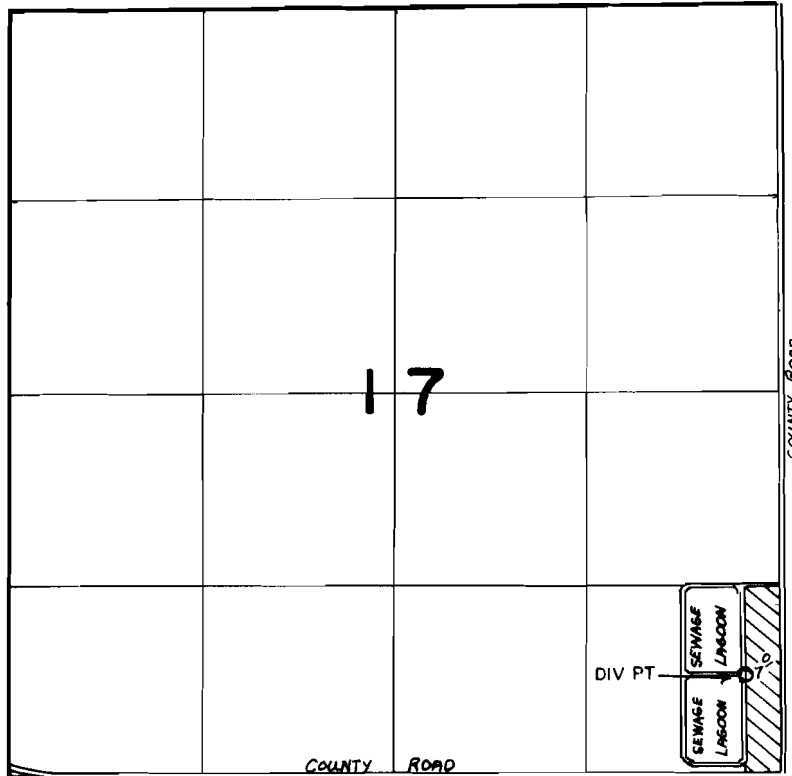

Div Pt Located 690'NB300'W From The SE Corner Of Section 17

**FINAL PROOF SURVEY**  
UNDER

56090                      R-7821  
Application No. 56091.... Permit No. 44105.....  
IN NAME OF

..... CITY OF COVE, OREGON .....

Surveyed ...7-10..... 1984.., by V.L.CHURCH.....