


T.13 S., R.16 E., W.M.

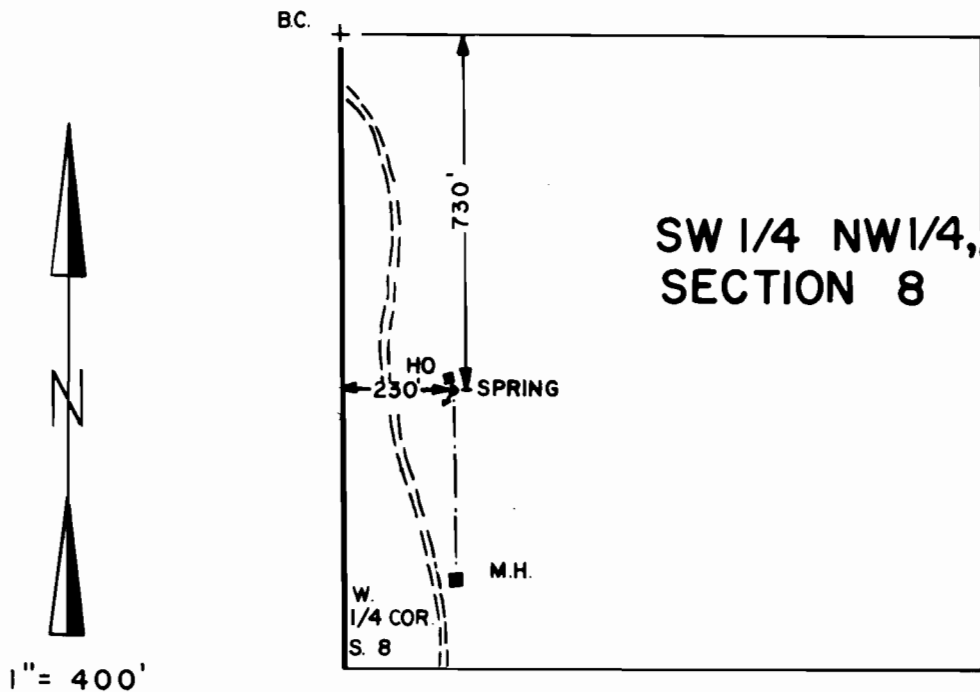

FINAL PROOF SURVEY
UNDER

Application No. 59170 Permit No. 44817
IN NAME OF

DONALD B. THELIN

Surveyed MARCH 8 1990, by B.W. BISHOP