


T. 22 S., R. 5 W., W. M.

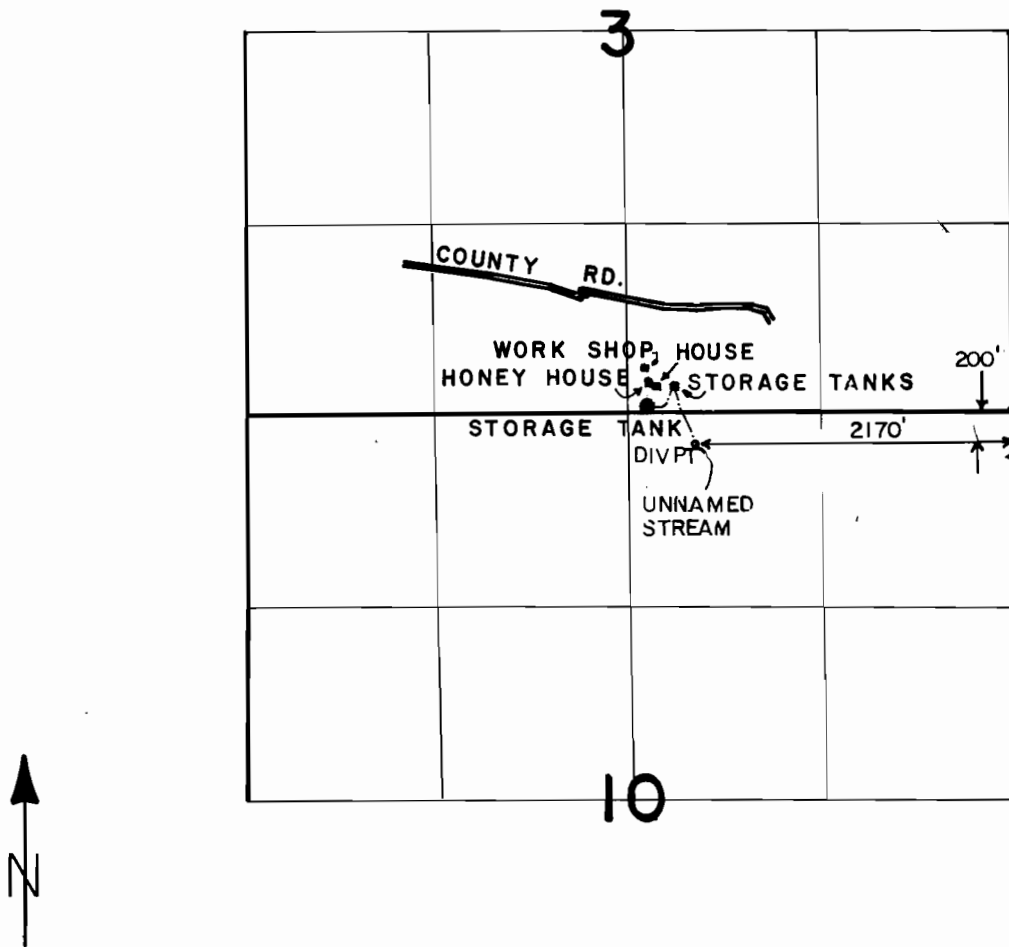

SCALE: 4" = 1 MILE

FINAL PROOF SURVEY
UNDER

Application No. 56158 42453
60101 Permit No. 46502
IN NAME OF

GARY ALAN WRIGHT & RICHARD CLEVELAND ALDRIDGE

Surveyed NOV. 9, 1987, by J. M. SCHMORDE