


# T. 28 S., R. 4 W., W.M.

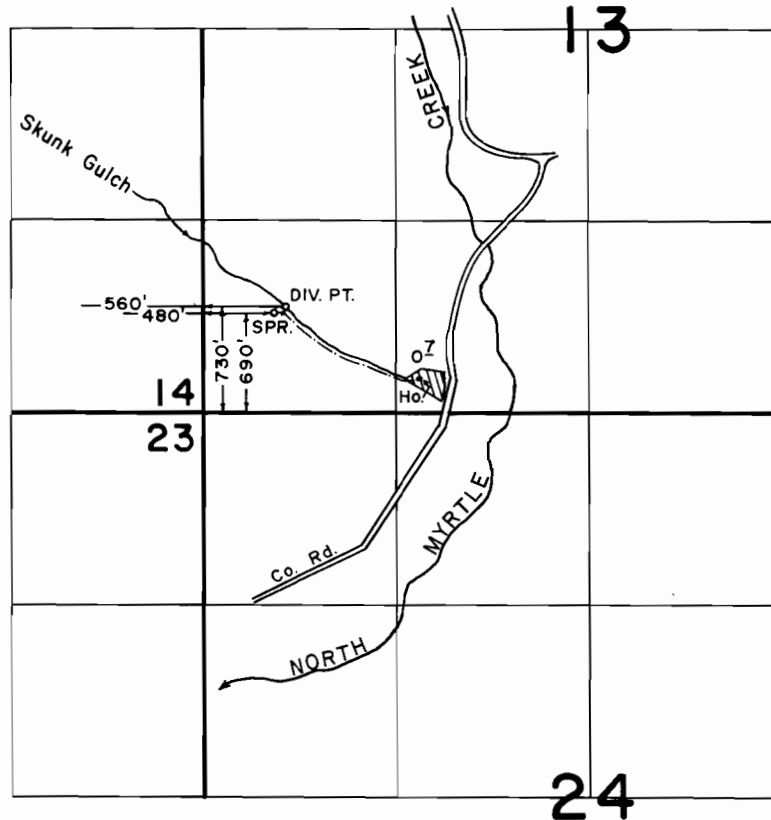

SCALE: 1" = 1320'

## FINAL PROOF SURVEY UNDER

60290                      45151  
Application No. 60291... Permit No. 45152.....

IN NAME OF

**FLOYD GIESE**

Surveyed MARCH 28 1990, by B. S. JAMES.....