


T. 35 S., R. 1 W., W. M.

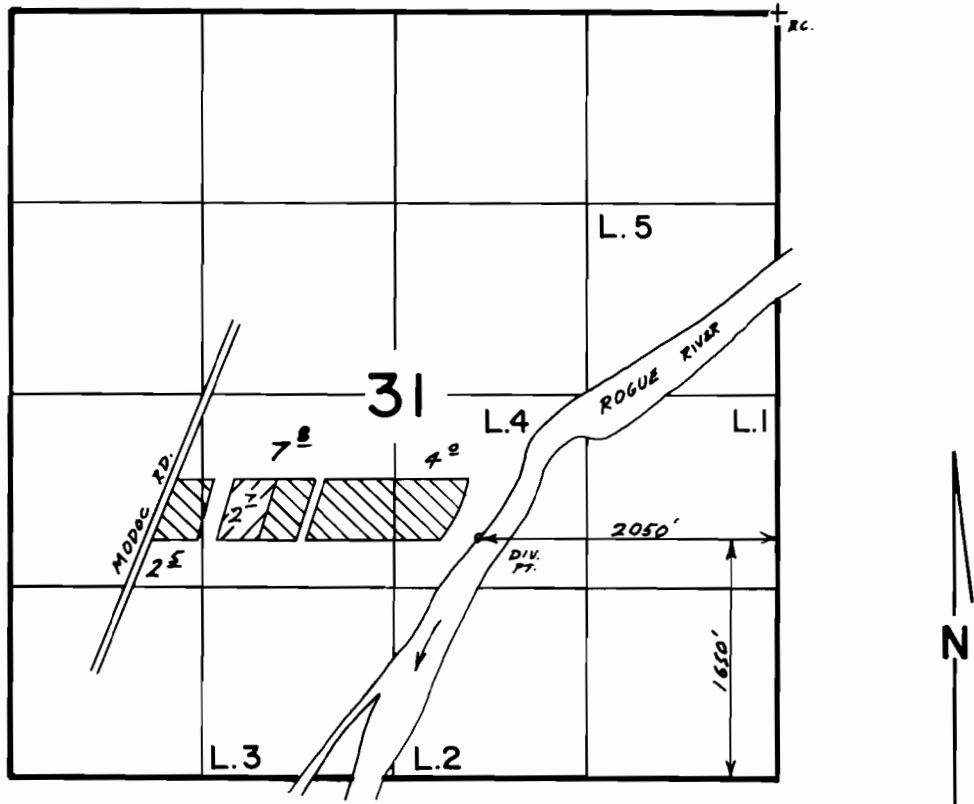

Scale 1" = 1320'

- TRANSFER
- PERMIT

FINAL PROOF SURVEY
UNDER

Transfer No. 4552

Application No. 60303 Permit No. 45006....
IN NAME OF

JIMMIE D. & PHILLIS WRAY.....

Surveyed MAY 14, 1987., by B.S. JAMES.....