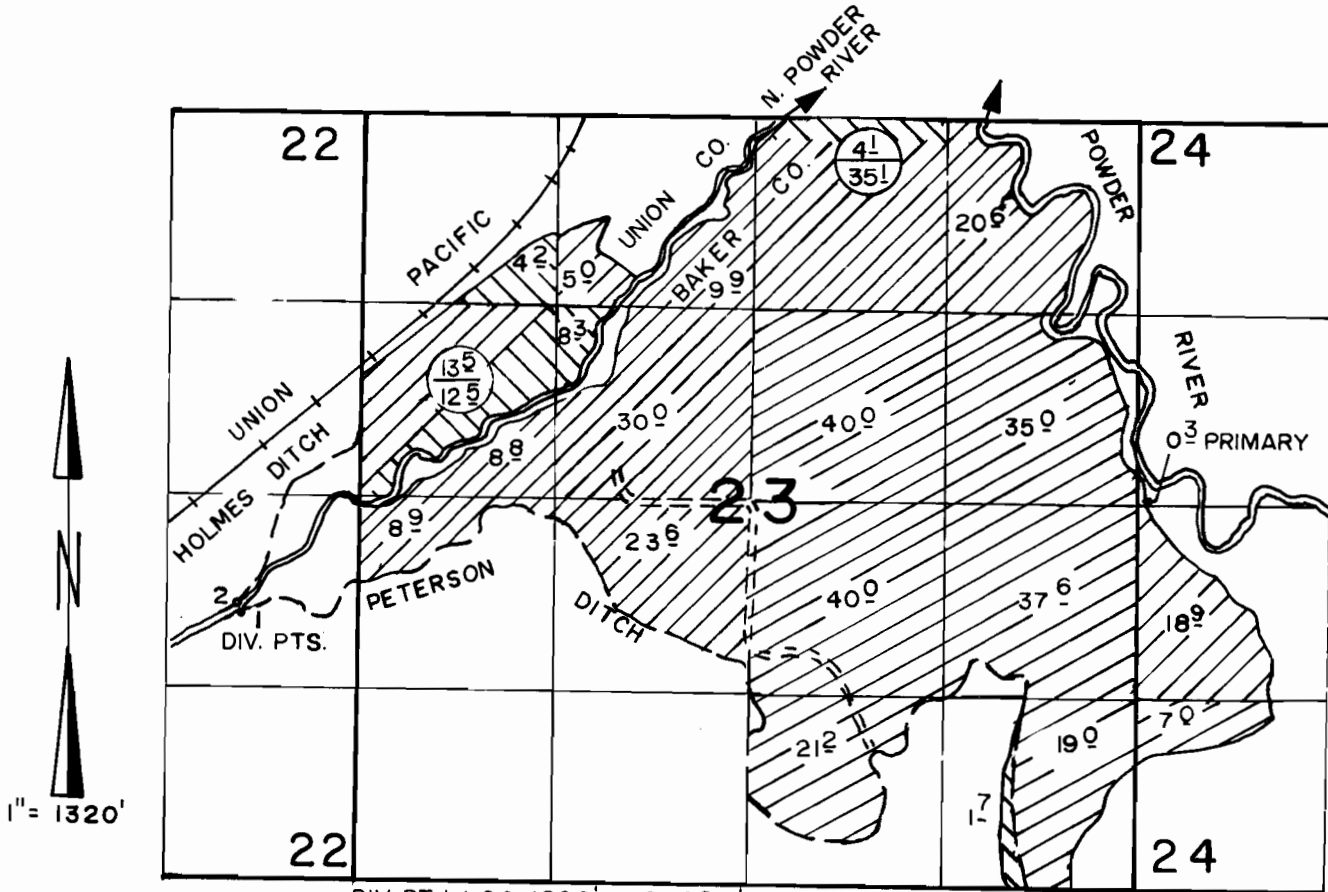

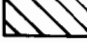
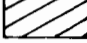


T.6 S., R. 39 E., W.M.



DIV. PT-1 LOC 1820' N. & 800' W. FROM S.E. COR. SEC. 22
 DIV. PT-2 LOC 1890' N. & 840' W. FROM S.E. COR. SEC. 22

-  SUPPLEMENTAL
-  PRIMARY
-  SUPPLEMENTAL WITH PRIMARY JULY & AUGUST ONLY

FINAL PROOF SURVEY UNDER

Application No. 60309 Permit No. 46184

IN NAME OF

U.S. DEPT. OF AGRICULTURE

Surveyed MARCH 13, 1990, by V.L. CHURCH