




T. 38 S., R. 10 E., W.M.

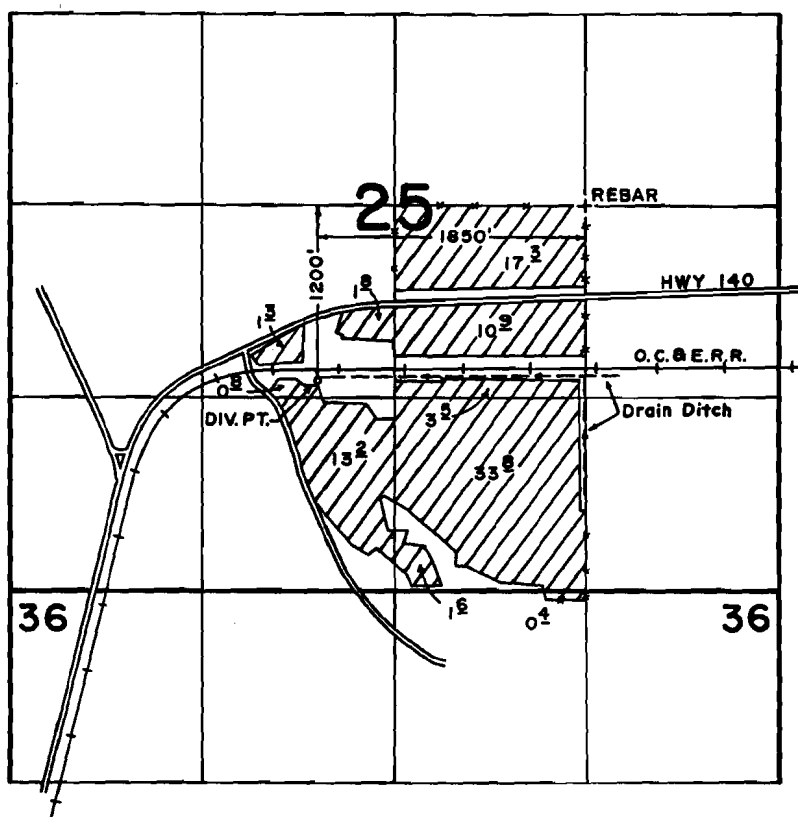

SCALE: 1" = 1320'

FINAL PROOF SURVEY UNDER

Application No. 61101... Permit No. 47022...
IN NAME OF

C. J. ROGERS

Surveyed APRIL 12 1990., by B. W. BISHOP...

5-29-90
PTS

psl