


T.38S., R.3W., W.M.

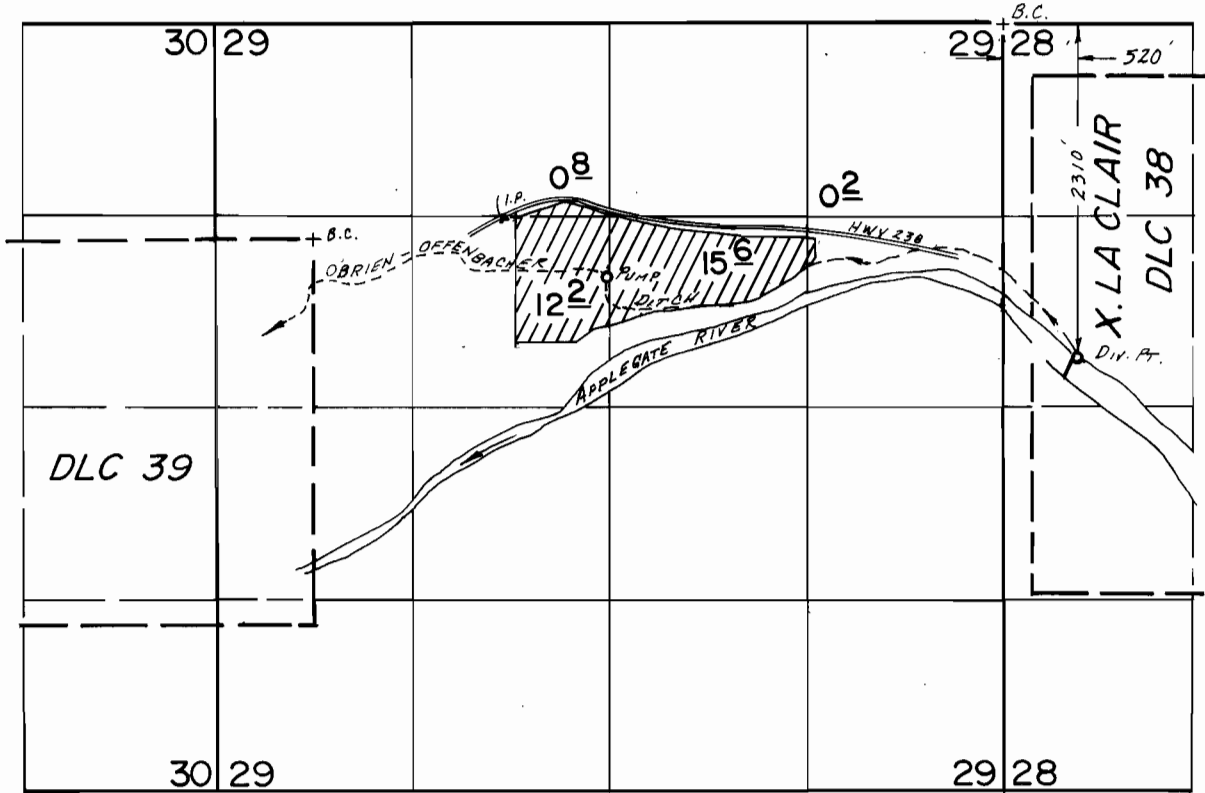

SCALE: 1" = 1320'

FINAL PROOF SURVEY UNDER

Application No. 62427.. Permit No. 47509.....
IN NAME OF

.....WILLIAM G. & JUNE B. HUGHES.....

Surveyed July 3..... 19.85, by B.S. JAMES.....