


T.15S., R.18E., W. M.

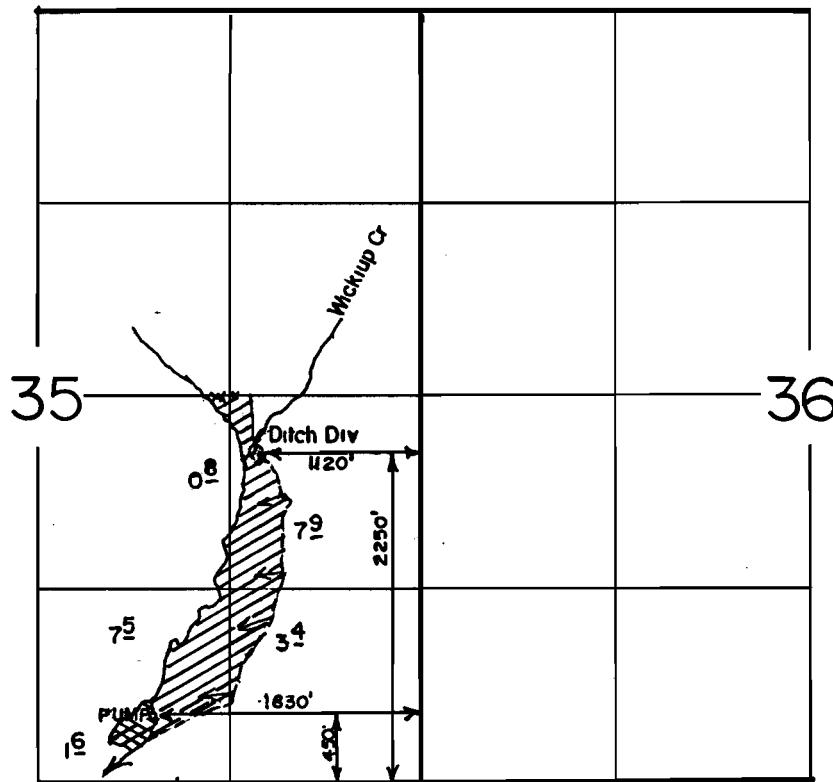

SCALE: 1"=1320'

FINAL PROOF SURVEY UNDER

Application No. 62753..... Permit No. 46589..... C 65026
IN NAME OF

..... ARCHIE D FOX

Surveyed FEB. 28. 1990., by L.J. CAREY.....