


T.22S., R.5 W., W.M.

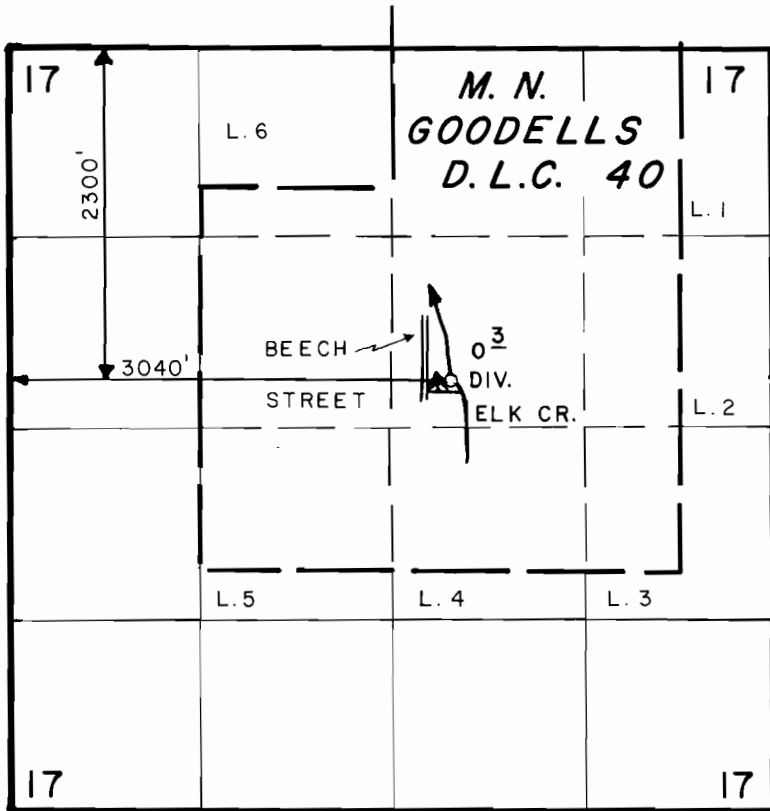

SCALE: 1" = 1320'

FINAL PROOF SURVEY UNDER

Application No. 63038. Permit No. 46648.....
IN NAME OF

LUCILLE LAND

Surveyed OCT. 23. 1986., by J. M. SCHMORDE