


# T.24S., R.15E., W.M.

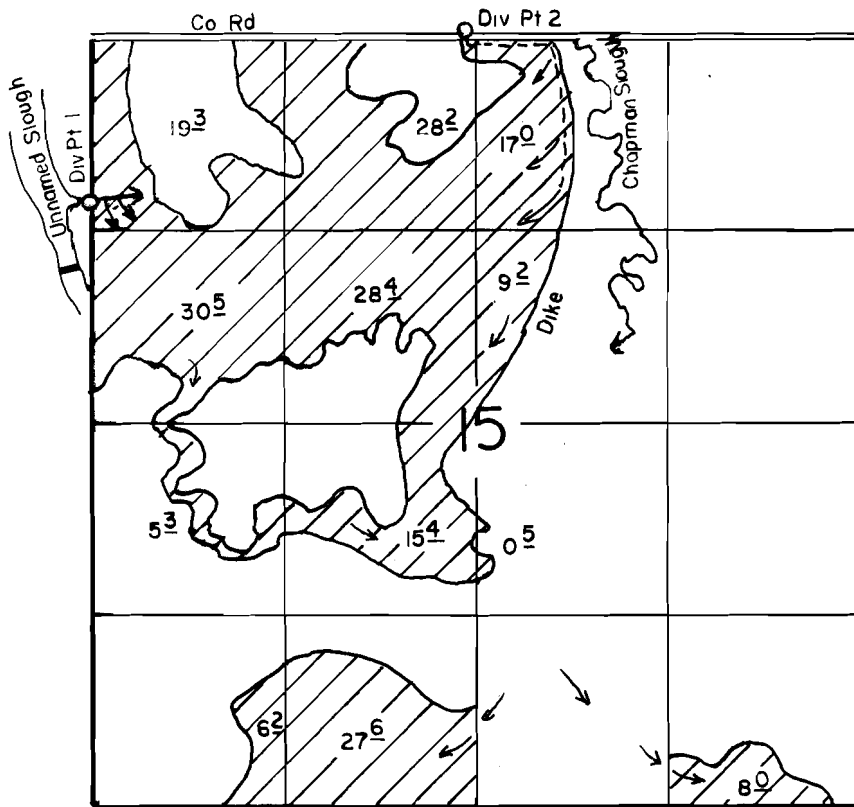

Div Pt 1 Loc 1100'S, Div Pt 2 Loc 30'N & 2560' E, Both From The NW Corner Of Section 15

SCALE: 1"=1320'

## FINAL PROOF SURVEY UNDER

Application No. 63231.... Permit No. 47094.....  
IN NAME OF

.....HELEN OPIE.....

Surveyed MAY 7..... 1989., by B.S. JAMES.....