90684

T. 1 N.,

R. 38E.,

W. M.

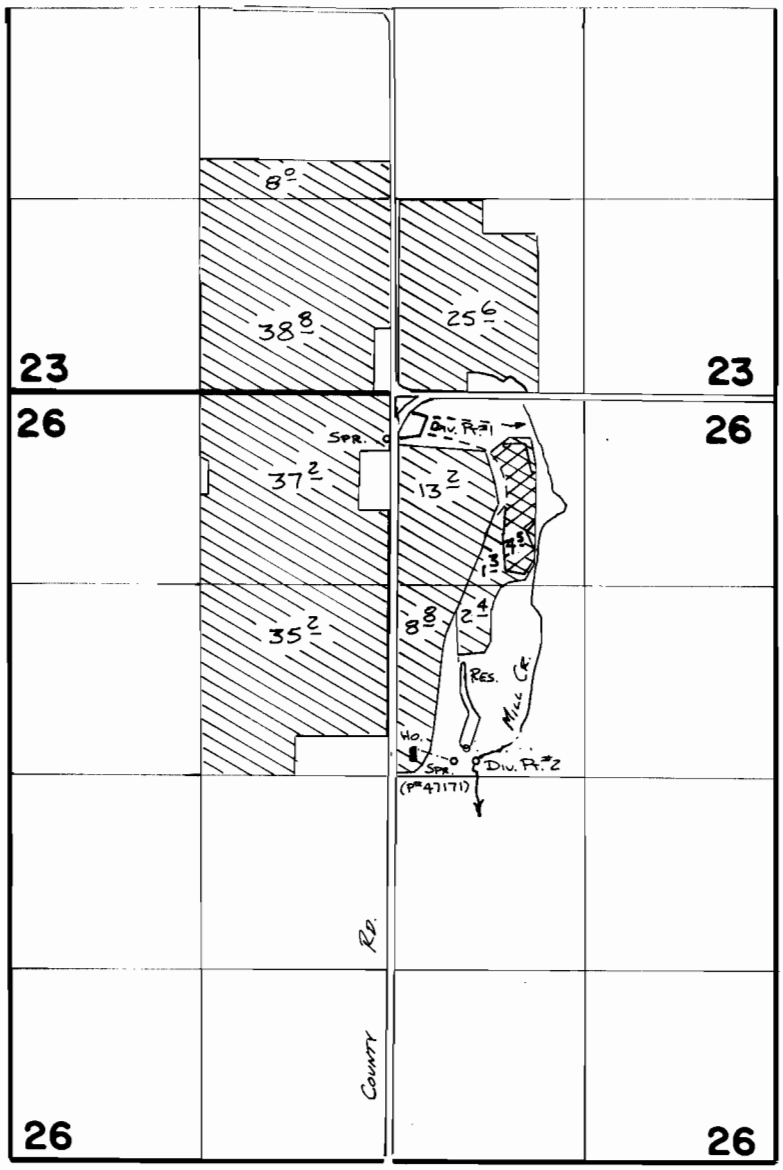

SCALE 1" = 1320'

SPRING LOC: 100'N. & 430'E. FROM CENTER COR. SEC 26
DIV. PT #1 LOC: 2350'N. & 200'E. FROM CENTER COR. SEC 26
DIV. PT. #2 LOC: 100'N. & 570'E. FROM CENTER COR SEC 26
RES LOC:- 200' N & 500' East from C/4, Sec 26

PER. 42260 PRIM

PER. 42260 SUPP'L

FINAL PROOF SURVEY

UNDER

56007	42259
56008	42260
R-56006	R-6693

Application No. 63253 Permit No. 47171

IN NAME OF

THOMAS & DOROTHY CRAIG

Surveyed 6-23 1987, by V.L. Church

41061-179-244L V.L.C.