


T.27S. R.6W. W.M.

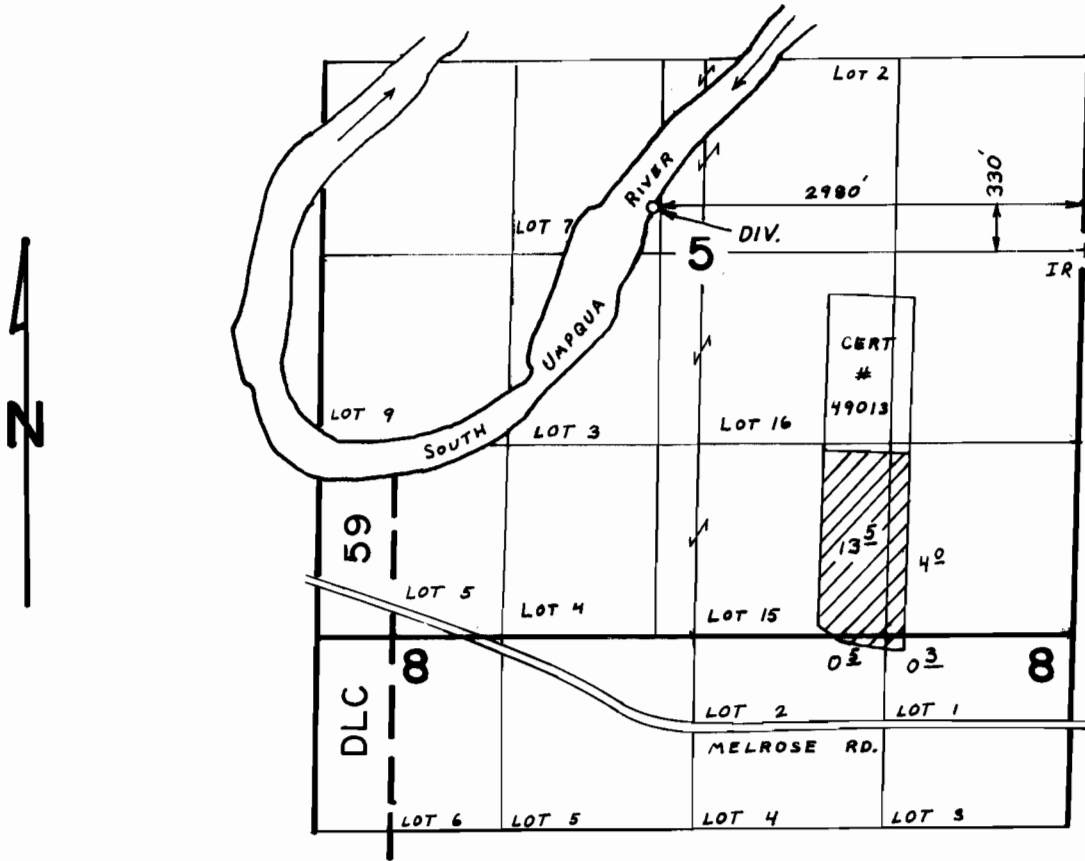

SCALE: 4" = 1 mile

FINAL PROOF SURVEY
UNDER

Application No. 63384 Permit No. 46749....
IN NAME OF

WILLIAM F. BONEBRAKE

Surveyed DEC. 2, 1983, by *L. Cashion*....