




T. 39 S., R. 11 E., W.M.

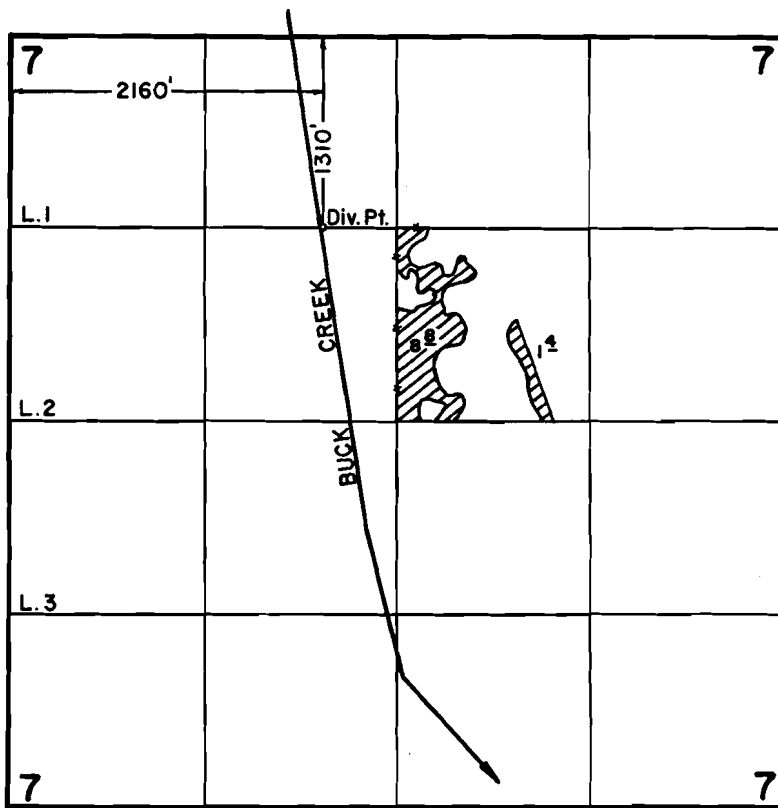

SCALE: 1" = 1320'

FINAL PROOF SURVEY
UNDER

Application No. 63444. Permit No. 46781.....
IN NAME OF

.....**GERALD GARCELON**.....

Surveyed SEPT. 12, 1989, by B. W. BISHOP....

11-16-89
41035-278-71D

for