


T. 27 & 28 S., R. 14 W., W.M.

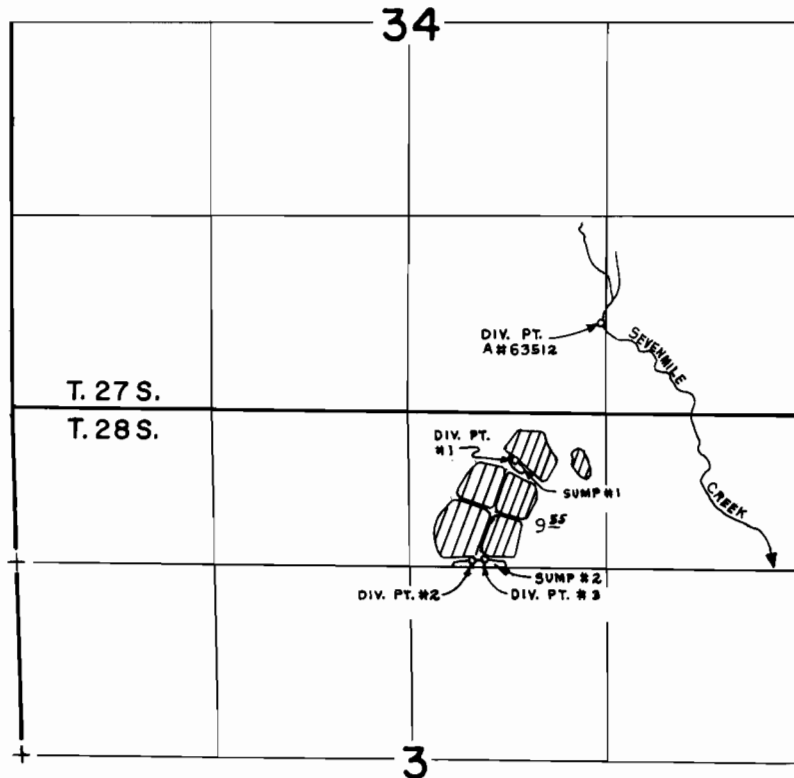

DIV. PT. #1 LOCATED 2,045' N. & 3,405' E. FROM W. 1/4 CORNER SECTION 3
 DIV. PT. #2 LOCATED 1,355' N. & 3,100' E. FROM W. 1/4 CORNER SECTION 3
 DIV. PT. #3 LOCATED 1,360' N. & 3,190' E. FROM W. 1/4 CORNER SECTION 3
 DIV. PT. A#63512 LOCATED 2,990' N. & 3,995' E., FROM W. 1/4 CORNER SECTION 3

SCALE: 4"=1 mile

FINAL PROOF SURVEY UNDER

63512 47254
 Application No. G-10855 Permit No. G-9966...
 IN NAME OF

MICHAEL NELSON RUSSELL

Surveyed SEPT. 11, 1984, by L. CASHION