


T.29 & 30S., R.11W., W.M.

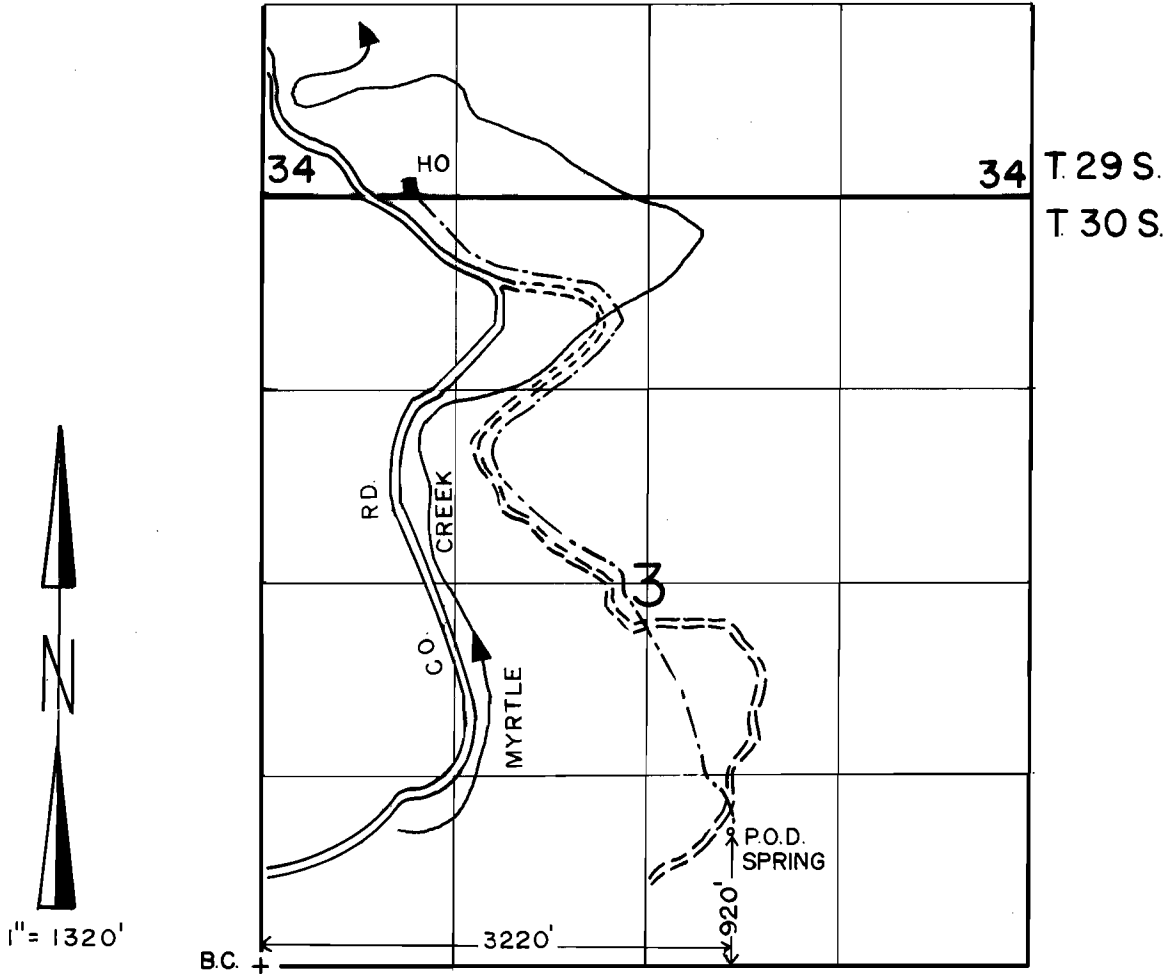

**FINAL PROOF SURVEY
UNDER**

Application No. 64528 Permit No. 47233
IN NAME OF

FRANCIS CARRINGTON

Surveyed JUNE 18 1990, by B.S. JAMES

7-3-90 DSM
41011-280-43L