


T. 31 S., R. 5 W., W.M.

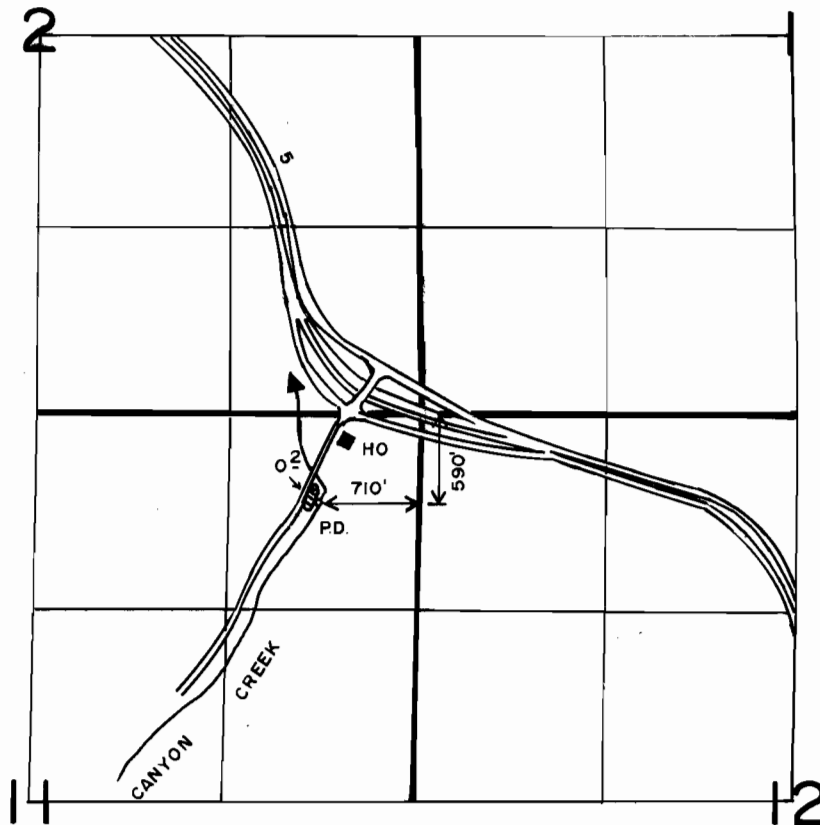

1" = 1320'

FINAL PROOF SURVEY UNDER

Application No. 65147 Permit No. 47823
IN NAME OF

BENNIE HUDGINS & WILLIAM H. ABEL

Surveyed APRIL 24 1990, by B. S. JAMES

7-26-90 DSM
41019-278-224 R