


T. 5 S., R. 1 E., W.M.

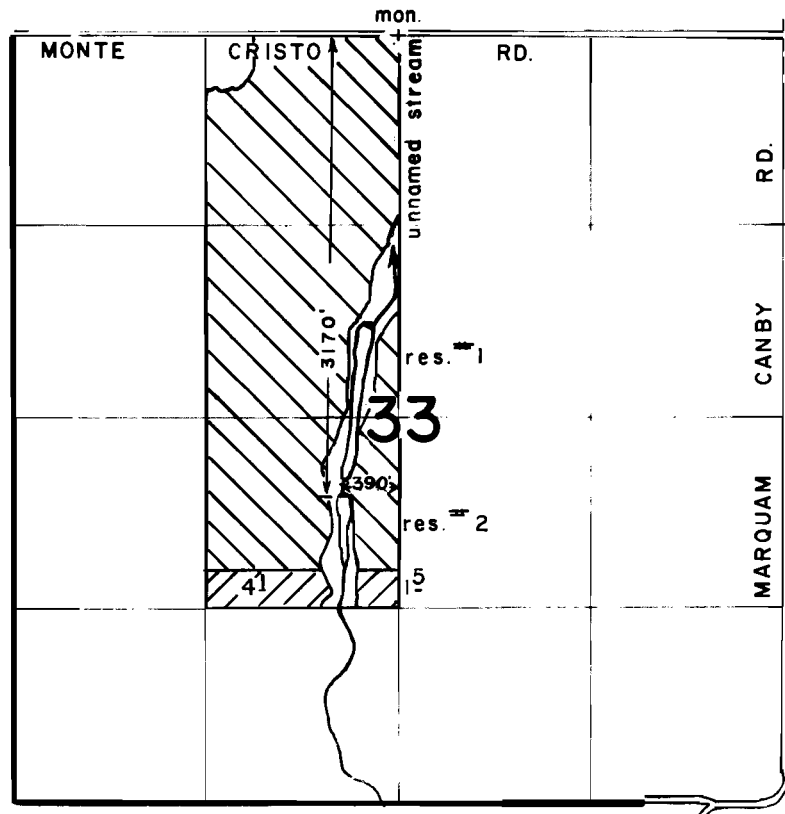

CERTIFICATE 56290



PERMIT 47876

**FINAL PROOF SURVEY
UNDER**

R-65215 R-8893
Application No. 65216 Permit No. 47876
IN NAME OF

EUGENE R. SCHMITZ

Surveyed JUNE 4 1990, by T.M. WARREN