




T. 28 S., R. 13 & 14 W., W.M.

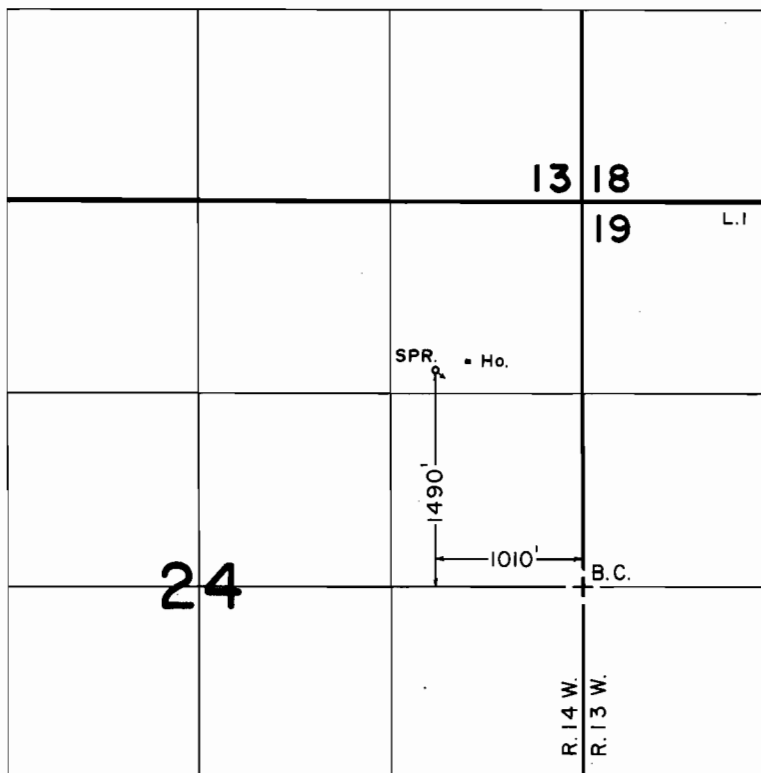

SCALE: 1" = 1320'

FINAL PROOF SURVEY
UNDER

Application No. 65323.. Permit No. 47695.....
IN NAME OF

RONALD JAMES & PATRICIA ANN EHLE

Surveyed APRIL 9, 1990, by B. S. JAMES.....