


T. 7 S., R. 1 E., W.M.

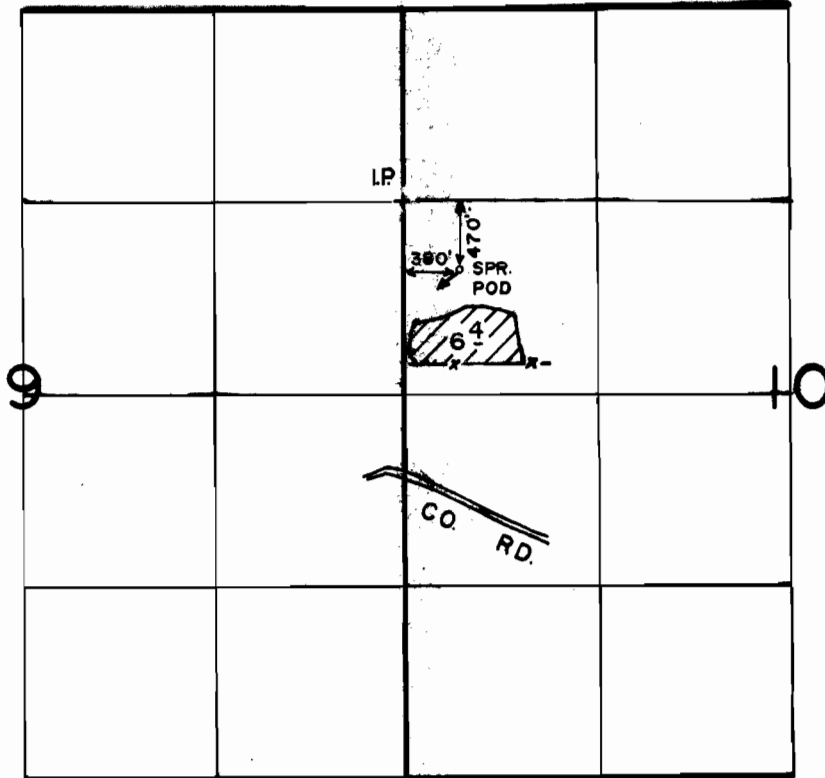

1" = 1320'

**FINAL PROOF SURVEY**  
UNDER

Application No. 66010 Permit No. 48098  
IN NAME OF

MARTHA JANE PEARCY

Surveyed JUNE 26 1990 by T.M. WARREN

7-30-90 DSM  
41047-178-17D