


T. 29 S., R. 4 W., W.M.

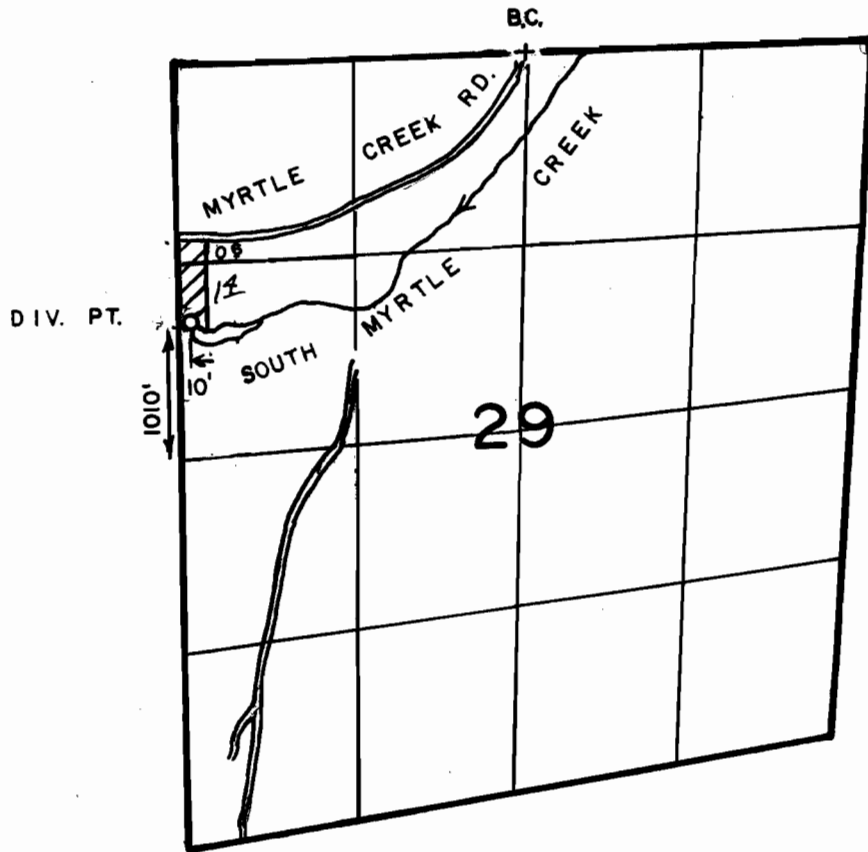

FINAL PROOF SURVEY
UNDER

Application No. 67320 Permit No. 48149
IN NAME OF

.....NORMAN G. KURZ.....

Surveyed MARCH 15 1990, by B.S. JAMES.....

4-5-90 DSM

41019-378-291L