


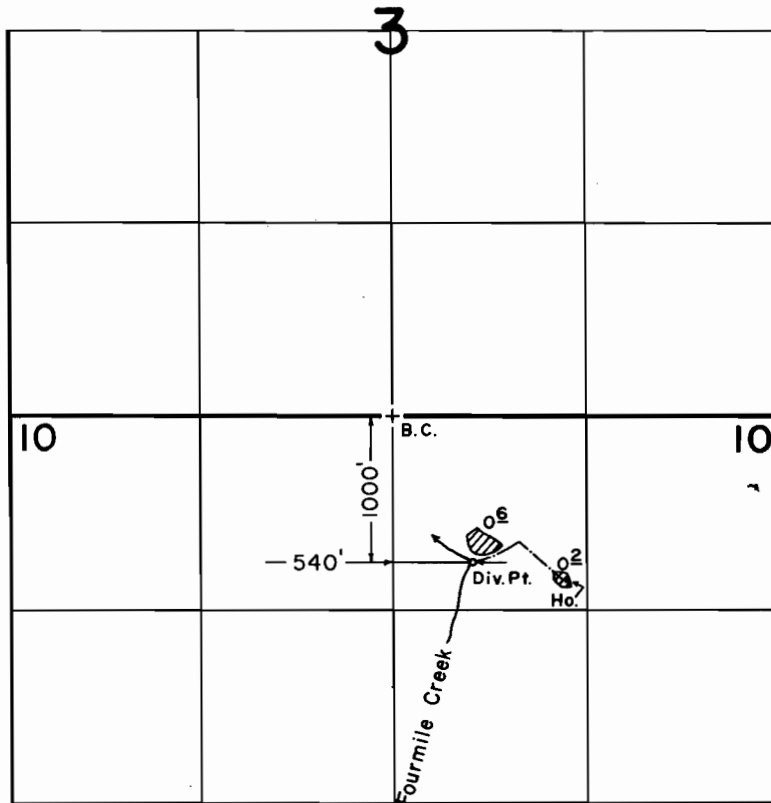

T. 30 S., R. 14 W., W.M.



SCALE: 1" = 1320'

**FINAL PROOF SURVEY**  
UNDER

Application No. 67350... Permit No. 48191.....  
IN NAME OF

**CLARENCE WILLIAM SCHULZE**

Surveyed APRIL 10 1990, by B. S. JAMES.....