




T. 23 S., R. 6 E., W.M.

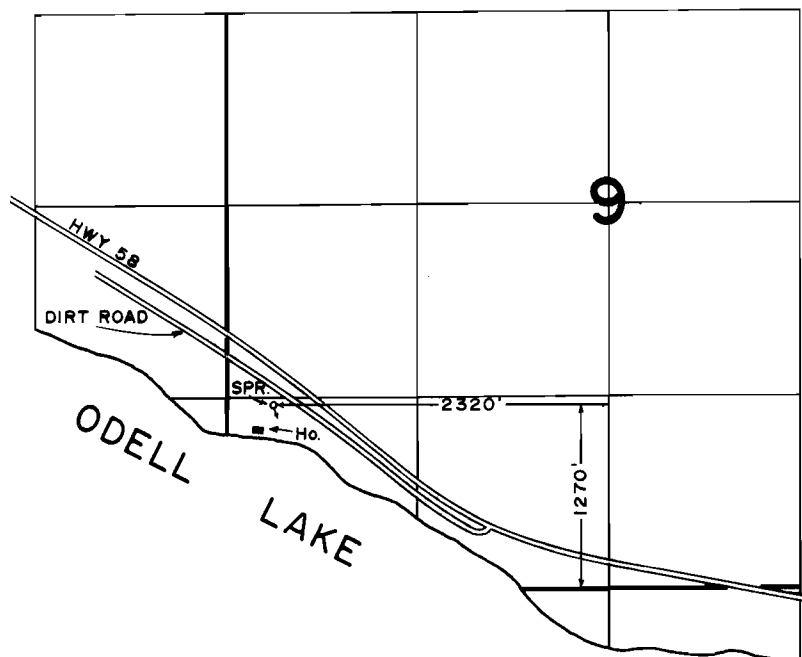

SCALE: 1" = 1320'

FINAL PROOF SURVEY
UNDER

Application No. 67721.. Permit No. 48409...
IN NAME OF

.....DURWARD L. BOYLES.....

Surveyed APRIL 19 1990, by B. W. BISHOP.

5-30-90
PTS