


T. 7 S., R. 1 E., W. M.

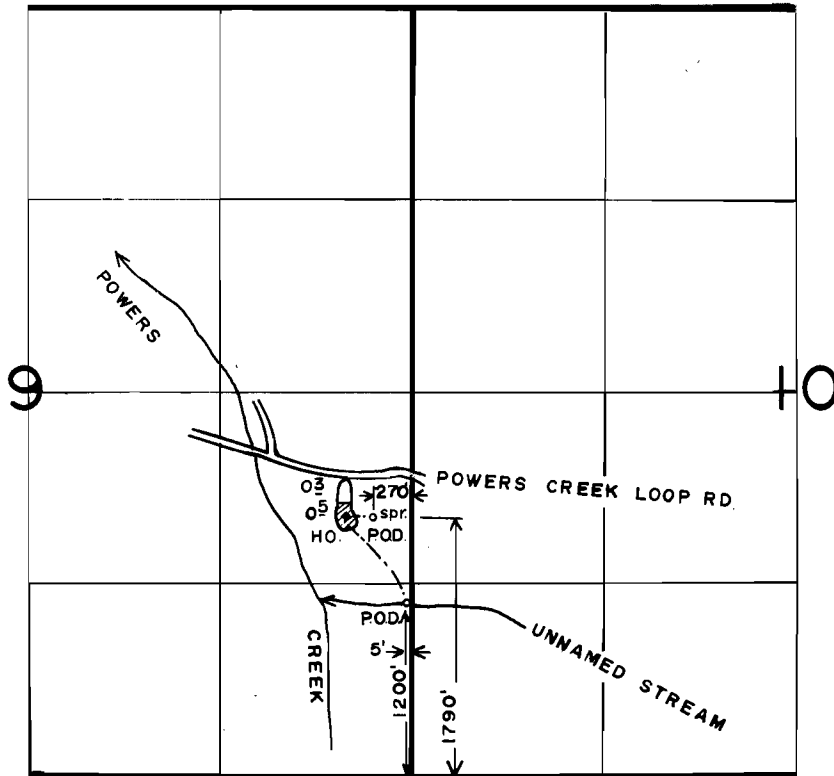

 OVER ACREAGE

**FINAL PROOF SURVEY
UNDER**

Application No. 68591 Permit No. 49559
IN NAME OF
SABINE LUCIER

Surveyed JUNE 26 19.90, by T.M. WARREN

7-30-90 DSM
DFN-4LL-66