


T. 30 S., R. 5 W., W.M.

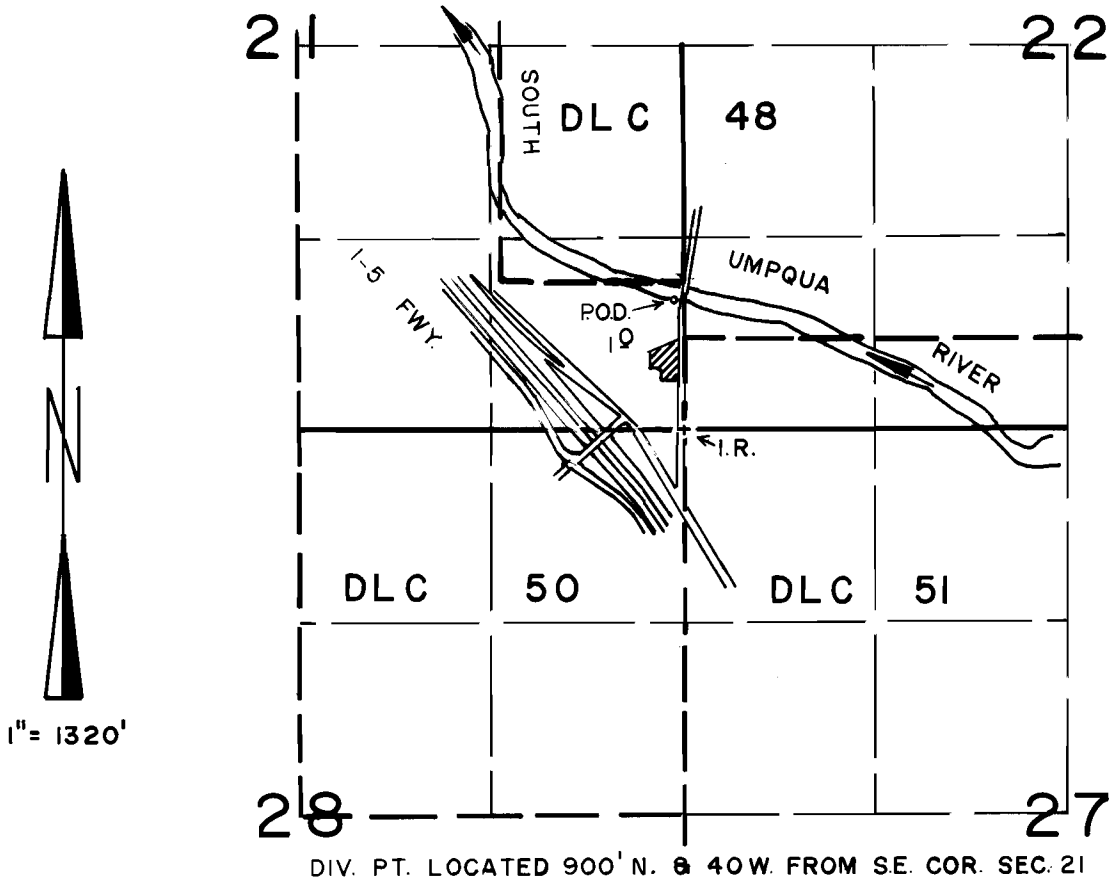

**FINAL PROOF SURVEY**  
UNDER

Application No. 68742... Permit No. 49707.....  
IN NAME OF

DENVIL & GENEVA KIMBLE

7-3-90 DSM

Surveyed APRIL 4 1990, by B.S. JAMES

41019-278-223 L