


T. 9 S., R. 2 W., W.M.

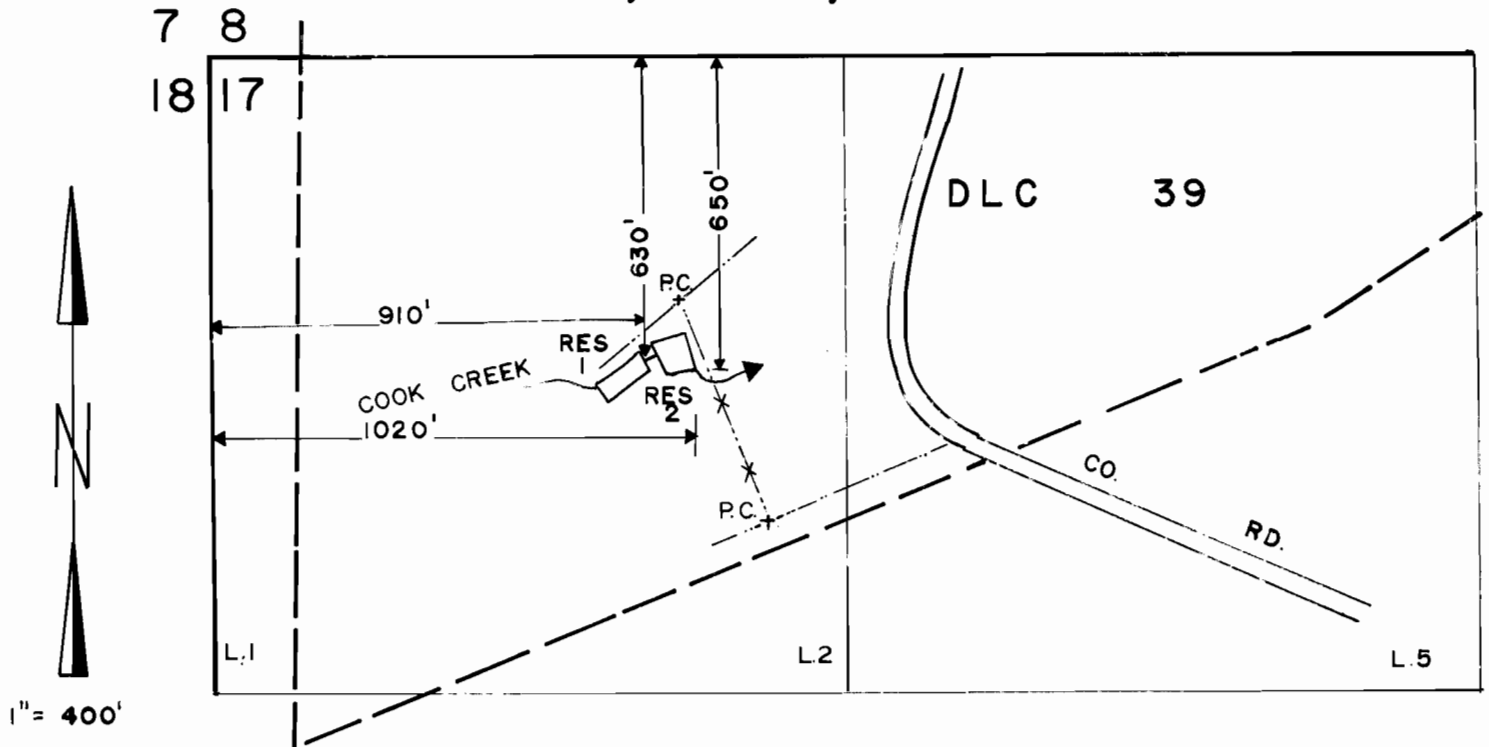

**FINAL PROOF SURVEY**  
UNDER

Application No. R-68973 Permit No. R-10828  
IN NAME OF

BARTON W. CUSSENS

Surveyed JUNE 25 1990, by T.M. WARREN

P.T.S.  
6-29-90 DSM