

FINAL PROOF SURVEY MAP

IN THE NAME OF GARY WEISS


SECTION 30, T28S, R4W, W.M.



1 INCH = 1320 FEET

APPLICATION R-69310

PERMIT R-1 1055

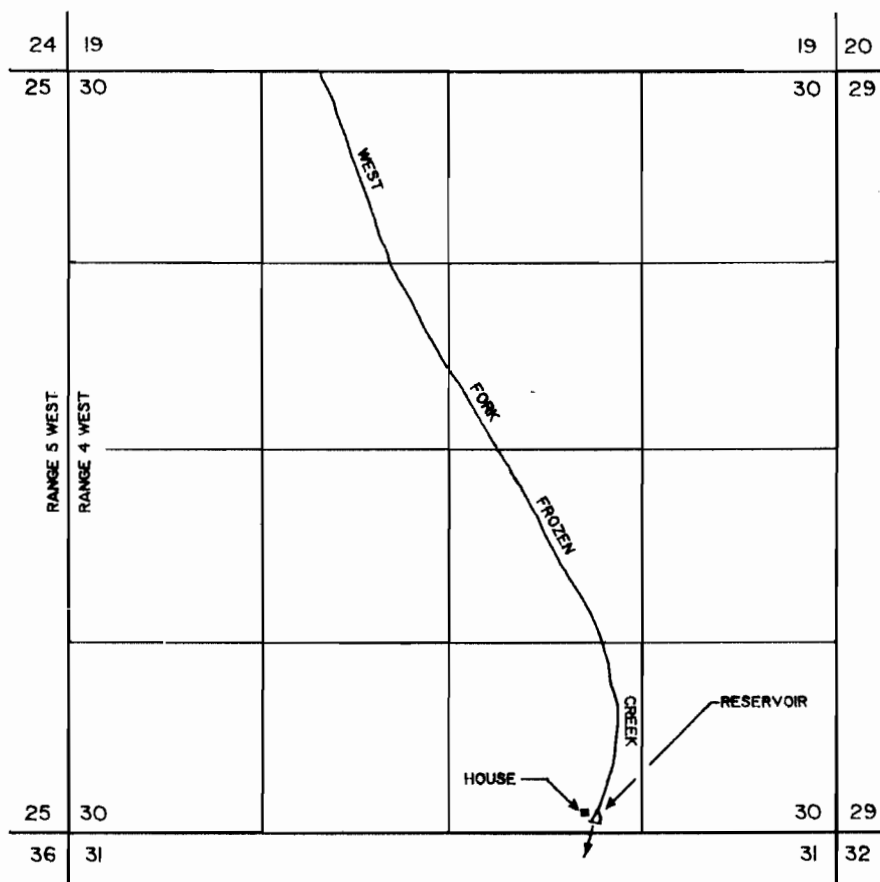

THE PURPOSE OF THIS MAP IS TO IDENTIFY THE LOCATION OF THE WATER RIGHT. IT IS NOT INTENDED TO PROVIDE INFORMATION RELATIVE TO THE LOCATION OF PROPERTY OWNERSHIP BOUNDARY LINES.

