


T.1N.,R3W.,W.M.

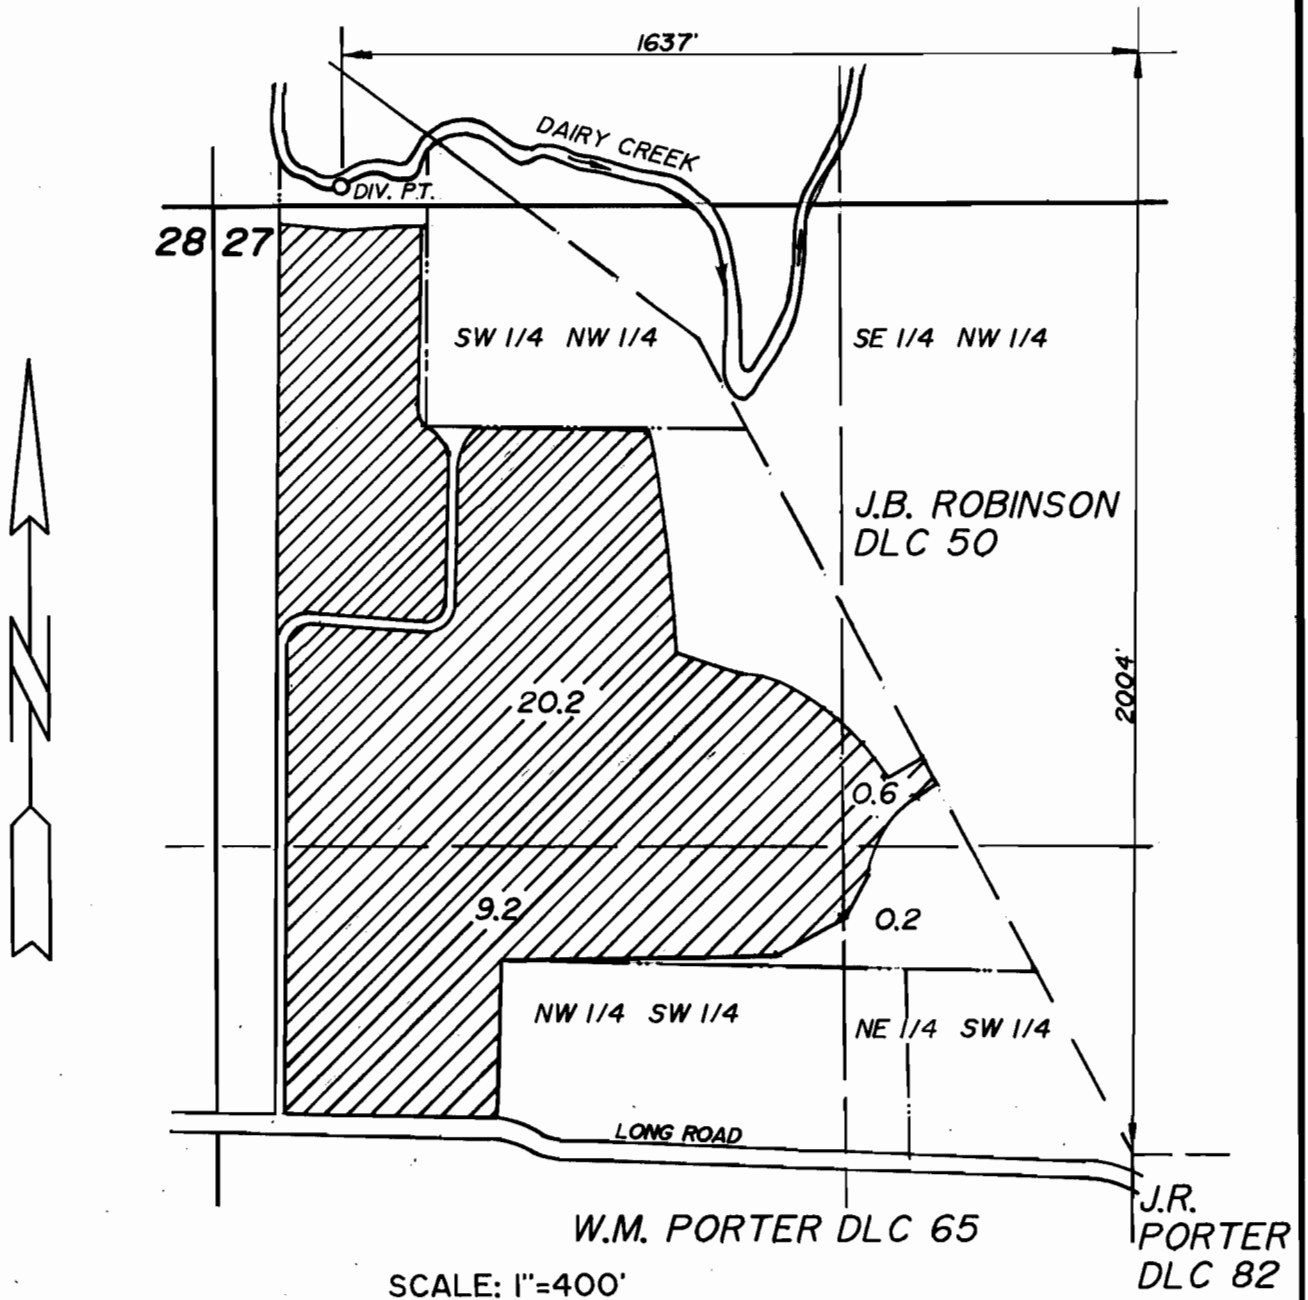

FINAL PROOF SURVEY
UNDER

Application No. 69498 Permit No. 50432

IN NAME OF

EDWIN H. & ETHEL J. DUYCK

Surveyed JAN. 19 1990 by *Andrew M. Klein*

