

FINAL PROOF SURVEY

T.38 S., R.8 W. W.M

APPLICATION NO. 69532

PERMIT NO. 50191


CERTIFICATE NO. _____

POINT OF DIVERSION IS LOCATED
810 FEET SOUTH AND 1190 FEET WEST
FROM THE NORTHEAST CORNER OF
SECTION 3, T. 38 S. R. 8 W. W.M.

POINT OF DOMESTIC USE (HOUSE)
IS LOCATED 595 FEET SOUTH AND
105 FEET EAST FROM SAID
SECTION CORNER.



SCALE: 1" = 400'

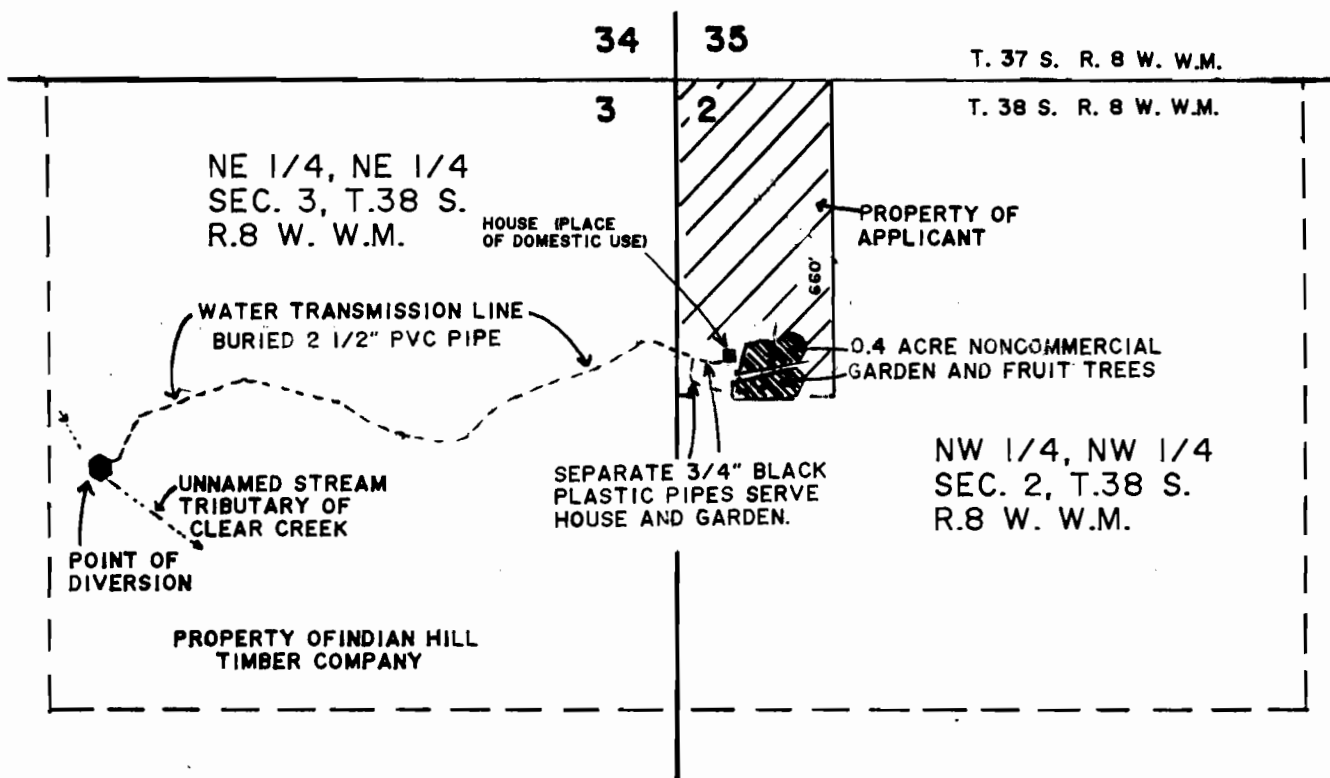

IN THE NAME OF
BETTY ANN & DAVID SMITH
P.O. BOX 88
SELMA, OREGON 97538

PREPARED BY:
JONATHAN C. SPERO W.R.E. # 123
1002 KINCAID RD./P.O. BOX 16
WILLIAMS, OREGON 97544
PHONE (503) 846-6845

OCTOBER 2, 1989

