



T. 23S. . R. 13W. . W. M.

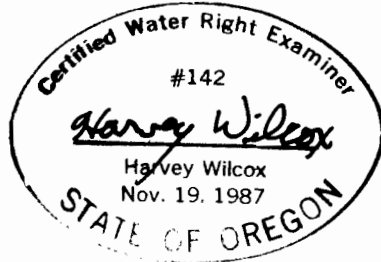

CE 1/16 S23

1/4 CORNER

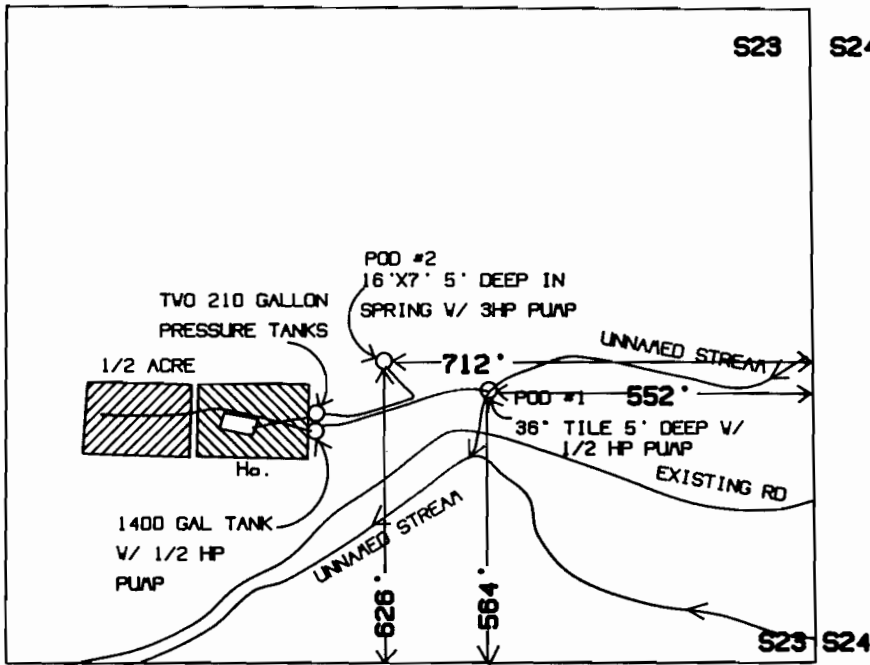

SE 1/16 S23 TO TENAILE CREEK

S1/16 SCALE 1" = 400'

LEGEND



IRRIGATION (POD #1)

DOMESTIC INCLUDING 1/2 ACRE (POD #2)

BASIS OF SURVEY WAS FROM AN AERIAL PHOTO

FINAL PROOF SURVEY

Application No. 70071.. Permit No. ..50772... IN NAME OF

ROLANDO MENEGAT

Surveyed .JANUARY 8 . 1990... by .H.A. WILCOX