

# FINAL PROOF SURVEY MAP


IN THE NAME OF BRANDY BAR LANDING  
HOMEOWNERS ASSOCIATION  
SECTION 6, T22S, R10W, W.M.

APPLICATION NO. 70092

PERMIT NO. 50809



SCALE: 1 INCH = 1320 FEET

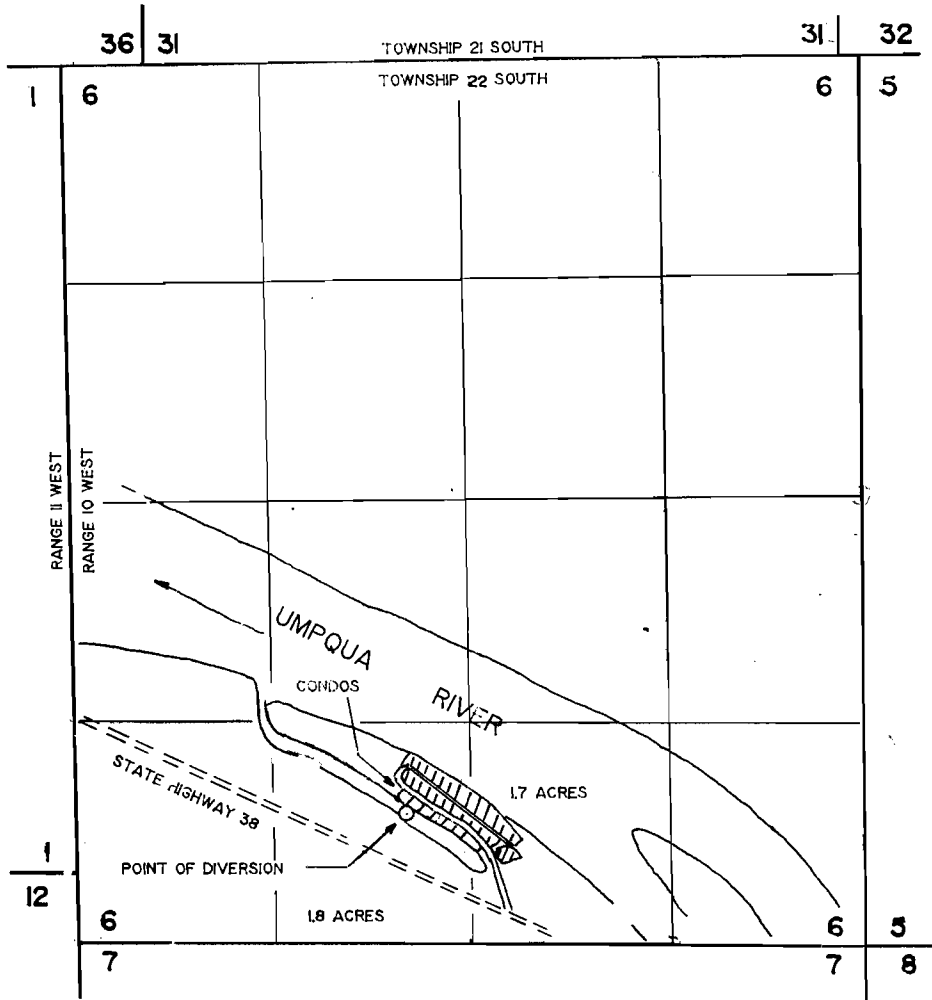

THE PURPOSE OF THIS MAP IS TO IDENTIFY THE LOCATION OF THE WATER RIGHT. IT IS NOT INTENDED TO PROVIDE INFORMATION RELATIVE TO THE LOCATION OF PROPERTY OWNERSHIP BOUNDARY LINES.

THE POINT OF DIVERSION IS LOCATED 690 FEET NORTH AND 2230 FEET EAST FROM THE SOUTHWEST CORNER OF SECTION 6, BEING WITHIN THE SOUTHEAST 1/4 OF THE SOUTHWEST 1/4 OF SECTION 6, TOWNSHIP 22 SOUTH, RANGE 10 WEST, W.M.

